

REGISTRATION NO. GR-295

CERTIFICATE NO. GR-267

# Registration Statement

## OF CLAIMANT OF RIGHT TO APPROPRIATE GROUND WATER

(Under Chapter 708, Oregon Laws 1955.)

TO THE STATE ENGINEER OF OREGON:

I, Larry Asboe RT 1, Mt Angel  

State of Oregon, do hereby make application for a certificate of registration as evidence of a right to appropriate ground water.

1. Source from which water is withdrawn is Pump well  
(Flowing well, pump well, infiltration trench, or tunnel)

2. Location is: 3/4 mile southwest of Morgan  
(Approximate distance and direction from nearest city or town)

and is more particularly described as follows:

(a) 1100 feet N and 1600 feet E of W 1/4 corner of section 9.  
3.8 rods N + 8 rods E of southwest corner of 40 acre  
SE 1/4 of NW 1/4 (Give distance and bearing to corner of section or other legal subdivision)

being within 40 acres of Sec. 9, Twp. 6 S, Rge. 1 E  
(Smallest legal subdivision) (N. or S.) (E. or W.)

(b) within limits of recorded platted property, town or city:

in Lot \_\_\_\_\_, Block \_\_\_\_\_ of \_\_\_\_\_  
(Name of plat or addition)  
(If within city or town, give name)

3. Construction Work was begun on June 1950; was completed on July 1950  
(Date) (Date)

and the ground water claimed was first used for the purposes set out below on 1950  
(Date)

since which time the water has been used continuously  
(Continuously or intermittently)

from 1950 to Nov 1956  
(Date) (Date)

4. Quantity of water claimed and used is 180 gallons per minute; \_\_\_\_\_ acre feet per year.

5. Purpose or Purposes for which water is used \_\_\_\_\_

Domestic irrigation  
(Domestic irrigation, municipal, manufacturing, industrial, etc.)

6. Description of Well: Depth 200 ft feet. Type drilled  
(Dug or drilled)

diameter 8 inches. Elevation of ground at well site 300 ft feet, mean sea level.  
(As near as known)

Depth to water table 165 feet.

7. Capacity of Well: \_\_\_\_\_ g.p.m. with \_\_\_\_\_ feet drawdown.

\_\_\_\_\_ g.p.m. with \_\_\_\_\_ feet drawdown.

Date of test \_\_\_\_\_

If Flowing Well: Measured discharge \_\_\_\_\_ g.p.m. on \_\_\_\_\_  
(Date)


Shut-in pressure at ground surface \_\_\_\_\_ lbs. per sq. in. on \_\_\_\_\_  
(Date)

Water is controlled by \_\_\_\_\_  
(Cap, valve, etc.)





Township 6 Range 1 E, W.M.  
North

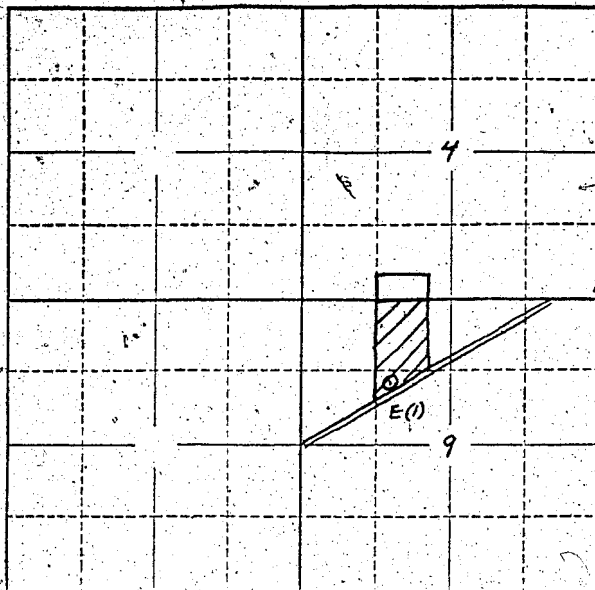

Locate well and acreage of irrigated land on plat.  
Scale: 2" = 1 Mile

STATE OF OREGON

County of \_\_\_\_\_ } ss.

I, Henry Asboe, being first duly sworn, do hereby certify that I have read the foregoing Registration Statement and that all of the items therein contained are true to the best of my knowledge and belief.

Henry Asboe  
(Signature of Registrant)

Subscribed and sworn to before me this 13th day of November, 1956.

My commission expires Sept 8, 1960  
Cliff S. ...  
(Notary Public)

(SEAL)

**CERTIFICATE OF REGISTRATION**

STATE OF OREGON } ss.  
County of Marion

This is to certify that the foregoing Registration Statement was received in the office of the State Engineer on the 13th day of November, 1956, at 1 o'clock P.M. and has been duly recorded in said office in Book No. 2 of Registration Statements on page GR-267-C.

~~Registration shall be completed by \_\_\_\_\_ 19\_\_\_\_ and the water completely applied to  
benefit use by \_\_\_\_\_ 19\_\_\_\_~~

Witness my hand this 15th day of January, 1957.

Levis A. Stanley  
(State Engineer)

By \_\_\_\_\_  
(Deputy)

GR-267C.