

Registration Statement

OF CLAIMANT OF RIGHT TO APPROPRIATE GROUND WATER

RECEIVED
JAN 25 1960

STATE ENGINEER
W. HALEM, JR.

TO THE STATE ENGINEER OF OREGON:

We, Pacific First Federal Savings & Loan Assn. c/o Norris, Beggs & Simpson, Agents,
of 711 S. W. Alder Street, Portland (Mailing address) County of Multnomah

State of Oregon do hereby make application for a certificate of registration as evidence of a right to appropriate ground water.

1. Source from which water is withdrawn is Pump well
(Flowing well, pump well, infiltration trench, or tunnel)

2. Location is: SW Sixth Avenue between Yamhill and Taylor Streets, Portland, Oregon.
(Approximate distance and direction from nearest city or town)

and is more particularly described as follows:

(a) Six feet North and six feet East of the southeast corner of Block 180, Portland
(Give distance and bearing to corner of section or other legal subdivision) Addition
being within NW 1/4 of NW 1/4 of Sec. 3 Twp. 1 S Rge. 1 E
(Smallest legal subdivision) (E. or W.)

or (b) within limits of recorded platted property, town or city:
in Lots 1 & 2, Block 180 of Portland Addition
(Name of plat or addition)

Portland County of Multnomah
(If within city or town, give name)

3. Construction Work was begun on April, 1955; was completed on June 30, 1955
(Date) (Date)

and the ground water claimed was first used for the purposes set out below on August, 1955
(Date)

since which time the water has been used intermittently, as required for space cooling.
(Continuously or intermittently)

from August 1955 to present date.
(Date) (Date)

4. Quantity of water claimed and used is 400 gallons per minute; acre
feet per year.

5. Purpose or Purposes for which water is used Air-conditioning the Executive building
at SW Sixth Avenue and Yamhill Street.
(Domestic, irrigation, municipal, manufacturing, industrial, etc.)

6. Description of Well: Depth 368 feet. Type drilled
(Dug or drilled)
diameter 14 inches. Elevation of ground at well site 58 feet, mean sea level.
(As near as known)
Depth to water table 230 feet to stratum used. Static, 48 feet.

7. Capacity of Well: 700 g.p.m. with 140 feet drawdown.
500 g.p.m. with 96 feet drawdown.

Date of test June, 1955

If Flowing Well: Measured discharge g.p.m. on
(Date)

Shut-in pressure at ground surface lbs. per sq. in. on
(Date)

Water is controlled by
(Cap, valve, etc.)

8. Casing: (Give diameter, commercial specifications and depth below ground surface of each casing size.)

14-3/8" inch diameter wall, steel casing from 10 to 264 feet
 inch diameter from to feet
 inch diameter from to feet
 inch diameter from to feet

Describe and show depth of shoe, plug, adapter, liner or other details:

9. Perforated Casings or Screens:

16 rows from 230 to 237
 (Number per foot and size of perforations, or describe screen)
 from to
 from to
 from to

10. Log of Well: (Describe each stratum or formation clearly, indicate if water bearing, and give thickness and depth as indicated.)

MATERIAL	Thickness (Feet)		Depth to Bottom (Feet)
	From	To	
Topsoil and fill	sidewalk		10
Brown packed sand	10		36
Cemented gravel	36		62
Sand and gravel, water	62		83
Cemented gravel	83		101
Brown sandy clay	101		113
Sand and gravel, blue clay binder	113		126
Sand and gravel, blue clay binder (some water).	126		140
Cemented gravel	140		155
Sand and gravel - blue clay binder (possible water)	155		165
Sand and gravel - tight blue clay binder	165		230
Loose gravel and sand - good water bearing formation	230		237
Blue clay - scattered gravel	237		267
Brown clay	267		300
Hard green shale ledge	300		302
Brown clay scattered green shale ledges	302		330
Hard brown shale	330		333
Brown clay	333		346
Brown and grey sandstone	346		352
Brown clay - scattered scab basalt	352		367
Grey basalt	367		368

If log of well is not available, give name and address of driller:

11. Infiltration Trench: Covered or open

Dimensions: Length ft. Minimum depth ft. Maximum depth ft.

Bottom width ft. Discharge g.p.m. Date of test

12. Tunnel: Type of lining

Dimensions:
(Length, course, and cross sectional size)

Position of water bearing stratum with reference to portal of tunnel:

Log of tunnel: (Preceding table for log of well may be used, if desired. Give footage from portal and character of materials, as pertinent.)

13. Pumping Equipment:

(a) Pump Worthington Corp., turbine type Capacity 400 g.p.m.
(Make, type and size)


(b) Motor 25 hp, 3-phase, 208-volt, AC motor
(Type and horsepower)

14. Location of area irrigated or to be irrigated, or place of use if for purposes other than irrigation.

Township North or South	Range E. or W. of Willamette Meridian	Section	Forty-acre Tract	Number Acres To Be Irrigated	Date of Reclamation
T1S	R1E	3	NW 1/4 + NW 1/4	Industrial	1955

15. If the ground water supply is supplemental to an existing water supply, identification of any application for a permit, permit, certificate, or adjudicated right to appropriate water made or held by the registrant.

Township 15 Range E W.M.
North

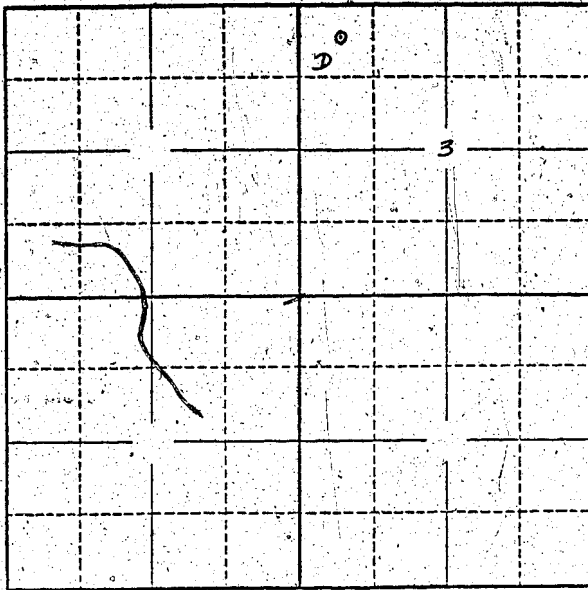

Locate well and acreage of irrigated land on plat.
Scale: 2" = 1 Mile

STATE OF OREGON

County of Multnomah } ss.

I, David B. Simpson, being first duly sworn, do hereby certify that I have read the foregoing Registration Statement and that all of the items therein contained are true to the Best of my knowledge and belief.

NORRIS, BEGGS & SIMPSON

By: David B. Simpson
(Signature of Registrant)

Subscribed and sworn to before me this 25 day of July, 1958

My commission expires Mar. 6, 1962

W. F. Brady
(Notary Public)

(SEAL)

CERTIFICATE OF REGISTRATION

STATE OF OREGON

County of Marion } ss.

This is to certify that the foregoing Registration Statement was received in the office of the State Engineer on the 29 day of July, 1958, at 8:00 o'clock A. M. and has been duly recorded in said office in Book No. 16 of Registration Statements on page GR 3932

Witness my hand this 15th day of February, 1960

Luvia A. Stanley
(State Engineer)

By _____
(Deputy)

\$20.00

GR 3932