

Registration No. GR. - 2951

Certificate No. GR. - 2770

Registration Statement**OF CLAIMANT OF RIGHT TO APPROPRIATE GROUND WATER****TO THE STATE ENGINEER OF OREGON:**

I, CYRIL A. & LORETTA JACOB
 of PT. 2, Box 392 County of TILLAMOOK
 (Mailing address)
 State of OREGON, do hereby make application for a certificate of registration as evidence
 of a right to appropriate ground water.

1. Source from which water is withdrawn is PUMP WELL
 (Flowing well, pump well, infiltration trench, or tunnel)
 2. Location is: 2 MILES SE of Tillamook, Ore.
 (Approximate distance and direction from nearest city or town)

and is more particularly described as follows:

- (a) 500 ft N + 300 ft E of SW corner of SE 1/4 Sec 32
 (Give distance and bearing to corner of section or other legal subdivision)
 being within SW 1/4 SE 1/4 of Sec. 32, Twp. 1 S, Rge. 9 W
 (Smallest legal subdivision) (N. or S.) (E. or W.)
 or (b) within limits of recorded platted property, town or city:
 in Lot _____, Block _____ of _____
 (Name of plat or addition)

(If within city or town, give name) County of _____

3. Construction Work was begun on August 20, 1938; was completed on Sept 1, 1938
 (Date) (Date)

and the ground water claimed was first used for the purposes set out below on Sept 1, 1938
 (Date)
 since which time the water has been used Intermittently
 (Continuously or intermittently)

from Aug 1938 to 1938
 (Date) (Date)

4. Quantity of water claimed and used is 200 gallons per minute; 3 acre
 feet per year.

5. Purpose or Purposes for which water is used Irrigation

(Domestic, irrigation, municipal, manufacturing, industrial, etc.)

6. Description of Well: Depth 118 feet. Type Drilled
 (Dug or drilled)
 diameter 8 inches. Elevation of ground at well site 70 feet, mean sea level.
 (As near as known)
 Depth to water table 15 feet.

7. Capacity of Well: 300 g.p.m. with 4 feet drawdown.
_____ g.p.m. with _____ feet drawdown.

Date of test _____

If Flowing Well: Measured discharge _____ g.p.m. on _____ (Date)

Shut-in pressure at ground surface _____ lbs. per sq. in. on _____ (Date)

Water is controlled by _____ (Cap, valve, etc.)

size.) (Give diameter, commercial specifications and depth below ground surface of each casing)

8 inch diameter from 0 to 2.8 feet
 inch diameter from to feet
 inch diameter from to feet
 inch diameter from to feet

Describe and show depth of shoe, plug, adapter, liner or other details: _____ to _____ feet

9. Perforated Casings or Screens:

(Number per foot and size of perforations, or describe screen)

from to

from _____ to _____


from to

from to

10. **Log of Well:** (Describe each stratum or formation clearly, indicate if water bearing, and give thickness and depth as indicated.)

[illegible]

Township 15th 2 S Range 9 W, W.M.
North

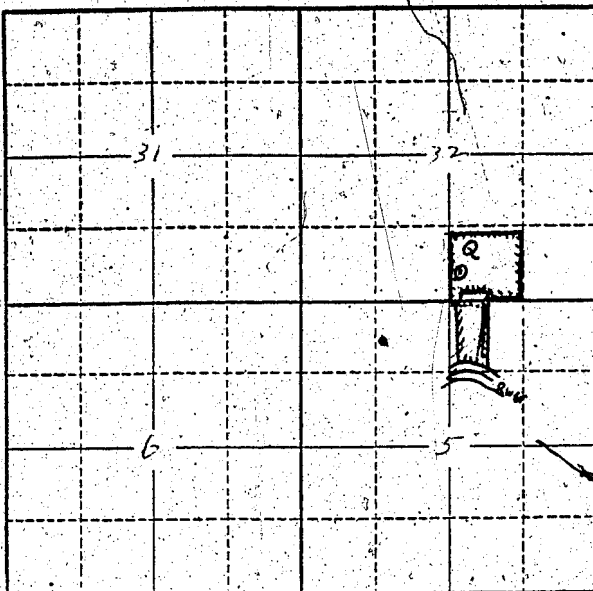

Locate well and acreage of irrigated land on plat.

Scale: 2" = 1 Mile

STATE OF OREGON

County of Tillamook

ss.

I, Cyril Jacob, being first duly sworn, do hereby certify that I have read the foregoing Registration Statement and that all of the items therein contained are true to the best of my knowledge and belief.

(Signature of Registrant)

Subscribed and sworn to before me this 25th day of July, 1930.

My commission expires July 1, 1931

(Notary Public)

(SEAL)

CERTIFICATE OF REGISTRATION

STATE OF OREGON

County of Marion

ss.

This is to certify that the foregoing Registration Statement was received in the office of the State Engineer on the 29 day of July, 1930, at 8:00 o'clock A.M. and has been duly recorded in said office in Book No. 12 of Registration Statements on page GR-2770

Witness my hand this 25th day of May, 1930

(State Engineer)

By

(Deputy)

GR - 2770