

Registration Statement

OF CLAIMANT OF RIGHT TO APPROPRIATE GROUND WATER

TO THE STATE ENGINEER OF OREGON:

I, Antone + Johanna Beeler
of Rt 1 Bay City, OREG County of Tillamook
(Mailing address)

State of ORE, do hereby make application for a certificate of registration as evidence of a right to appropriate ground water.

- 1. Source from which water is withdrawn is pump well
(Flowing well, pump well, infiltration trench, or tunnel)
- 2. Location is: 1 1/2 miles Northwest of Tillamook, ORE
(Approximate distance and direction from nearest city or town)

and is more particularly described as follows:

(a) 650 ft S. and 310 ft E. of N.W. Corner of SW 1/4 of Sect. 24
(Give distance and bearing to corner of section or other legal subdivision)
being within NW 1/4 of SW 1/4 of Sec. 24, Twp. 15, Rge. 10 W
(Smallest legal subdivision) (N. or S.) (E. or W.)

or (b) within limits of recorded platted property, town or city:

in Lot _____, Block _____ of _____
(Name of plat or addition)

County of _____
(If within city or town, give name)

3. Construction Work was begun on May 1951; was completed on June 1951
(Date) (Date)

and the ground water claimed was first used for the purposes set out below on June 1951
(Date)

since which time the water has been used intermittently (May-Oct)
(Continuous or intermittently)

from 1951 to 1958
(Date) (Date)

4. Quantity of water claimed and used is 184 gallons per minute; 2-3 acre feet per year.

5. Purpose or Purposes for which water is used irrigation
(Domestic, irrigation, municipal, manufacturing, industrial, etc.)

6. Description of Well: Depth 115 feet. Type drilled
(Dug or drilled)
diameter 9 inches. Elevation of ground at well site 5 feet, mean sea level.
(As near as known)

Depth to water table 8 feet.

7. Capacity of Well: 184 g.p.m. with 9 feet drawdown.
_____ g.p.m. with _____ feet drawdown.

Date of test actual field use

If Flowing Well: Measured discharge _____ g.p.m. on _____
(Date)

Shut-in pressure at ground surface _____ lbs. per sq. in. on _____
(Date)

Water is controlled by _____
(Cap, valve, etc.)

If log of well is not available, give name and address of driller.

11. Infiltration Trench: Covered or open

Dimensions: Length ft. Minimum depth ft. Maximum depth ft.

Bottom width ft. Discharge g.p.m. Date of test

12. Tunnel: Type of lining

Dimensions:
(Length, course, and cross sectional size)

Position of water bearing stratum with reference to portal of tunnel

Log of tunnel: (Preceding table for log of well may be used, if desired. Give footage from portal and character of materials, as pertinent.)

13. Pumping Equipment:

(a) Pump Capacity 200 g.p.m.
(Make, type and size)


(b) Motor 5. H. P. Electric
(Type and horsepower)

14. Location of area irrigated or to be irrigated, or place of use if for purposes other than irrigation.

| Township North or South | Range E. or W. of Willamette Meridian | Section | Forty-acre Tract | Number Acres To Be Irrigated | Date of Reclamation |
|-------------------------|---------------------------------------|---------|------------------|------------------------------|---------------------|
| 15 | 10 W | 24 | SW 1/4 NW 1/4 | 11.6 | 1951 |
| 15 | 10 W | 24 | NW 1/4 SW 1/4 | 31.1 | " |
| 15 | 10 W | 24 | SW 1/4 SW 1/4 | 3.4 | " |
| 15 | 10 W | 23 | SE 1/4 NE 1/4 | 10.8 | " |
| 15 | 10 W | 23 | NE 1/4 SE 1/4 | 9.9 | " |
| 15 | 10 W | 23 | SE 1/4 SE 1/4 | <u>4.8</u> | " |
| | | | Total | 71.6 acres | " |

15. If the ground water supply is supplemental to an existing water supply, identification of any application for a permit, permit, certificate or adjudicated right to appropriate water made or held by the registrant.

Township 15 Range 10 W., W.M.
North

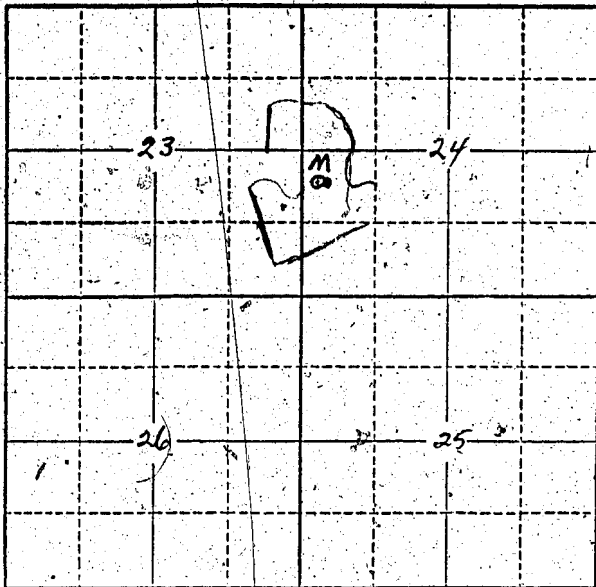

Locate well and acreage of irrigated land on plat.
Scale: 2" = 1 Mile

STATE OF OREGON

County of Tillamook } ss.

I, Anton Beeler, being first duly sworn, do hereby certify that I have read the foregoing Registration Statement and that all of the items therein contained are true to the best of my knowledge and belief.

Anton Beeler
(Signature of Registrant)

Subscribed and sworn to before me this 26th day of July, 1958.

My commission expires July 18-1960

W. Beuschel
(Notary Public)

(SEAL)

CERTIFICATE OF REGISTRATION

STATE OF OREGON } ss.
County of Marion

This is to certify that the foregoing Registration Statement was received in the office of the State Engineer on the 29 day of July, 1958, at 8.00 o'clock A.M. and has been duly recorded in said office in Book No. 12 of Registration Statements on page GR-2771

Witness my hand this 25th day of May, 1959

Stuart A. Stanley
(State Engineer)

By _____
(Deputy)

\$ 21.30