

# Registration Statement

## OF CLAIMANT OF RIGHT TO APPROPRIATE GROUND WATER

TO THE STATE ENGINEER OF OREGON:

I, JOHN J. MERTZ

of Rt. 1, Stayton, Oregon County of Marion

State of Oregon, do hereby make application for a certificate of registration as evidence of a right to appropriate ground water.

1. Source from which water is withdrawn is dug water hole  
(Flowing well, pump well, infiltration trench, or tunnel)

2. Location is: approximately one half mile from Stayton, Oregon  
(Approximate distance and direction from nearest city or town)

and is more particularly described as follows:

(a) Approximately 175 feet Southeast from the center of Section 9  
(Give distance and bearing to corner of section or other legal subdivision)  
being within NW 1/4 SE 1/4 of Sec. 9, Twp. 9 South, Rge. 1 West  
(Smallest legal subdivision) (N. or S.) (E. or W.)

or (b) within limits of recorded platted property, town or city:

in Lot \_\_\_\_\_, Block \_\_\_\_\_ of \_\_\_\_\_  
(Name of plat or subdivision)  
County of \_\_\_\_\_  
(If within city or town, give name)

3. Construction Work was begun on Sept. 1952; was completed on Sept. 1952  
(Date) (Date)

and the ground water claimed was first used for the purposes set out below on June 1953  
(Date)

since which time the water has been used continuously  
(Continuously or intermittently)

from June 1953 to July 26, 1958  
(Date) (Date)

4. Quantity of water claimed and used is 180 gallons per minute; \_\_\_\_\_ acre feet per year.

5. Purpose or Purposes for which water is used irrigation

6. Description of <sup>dug hole</sup>~~well~~ (Domestic, irrigation, municipal, manufacturing, industrial, etc.)  
Depth 16 feet. ~~Type~~ 20 ft. by 50 ft. <sup>Dug</sup>  
(As dug or drilled)

diameter \_\_\_\_\_ inches. Elevation of ground at well site \_\_\_\_\_ feet, mean sea level.  
(As near as known)

Depth to water table \_\_\_\_\_ feet.

7. Capacity of Well: No test g.p.m. with \_\_\_\_\_ feet drawdown.

\_\_\_\_\_ g.p.m. with \_\_\_\_\_ feet drawdown.

Date of test \_\_\_\_\_

If Flowing Well: Measured discharge \_\_\_\_\_ g.p.m. on \_\_\_\_\_  
(Date)

Shut-in pressure at ground surface \_\_\_\_\_ lbs. per sq. in. on \_\_\_\_\_  
(Date)


Water is controlled by \_\_\_\_\_  
(Cap, valve, etc.)





Township 9 South Range 1 West, W.M.  
North

Water hole - App.  
175 ft Southeast  
from the center of  
Sec. 9, 9-1-W

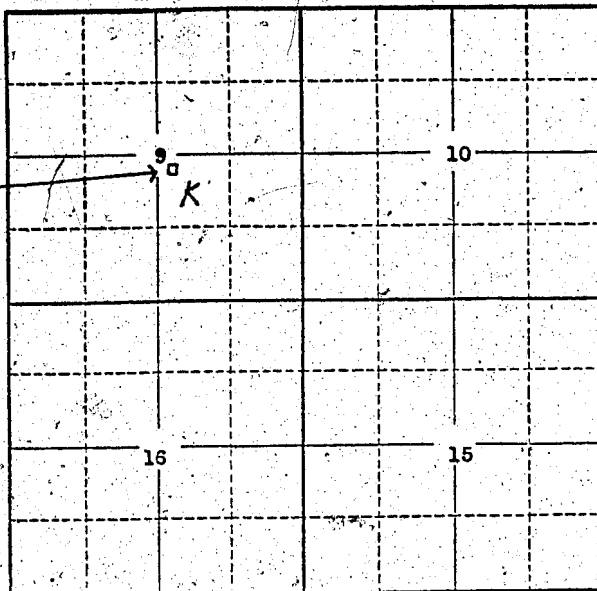

Locate well and acreage of irrigated land on plat.  
Scale: 2" = 1 Mile

STATE OF OREGON

County of Marion } ss.

I, JOHN J. MERTZ, being first duly sworn, do hereby certify that I have read the foregoing Registration Statement and that all of the items therein contained are true to the best of my knowledge and belief.

*John J. Mertz*  
(Signature of Registrant)

Subscribed and sworn to before me this \_\_\_\_\_ day of July, 19 58.

My commission expires Sept. 20, 1959.

*George R. Duncan Jr.*  
(Notary Public) for Oregon.

(SEAL) 1

CERTIFICATE OF REGISTRATION

STATE OF OREGON

County of Marion } ss.

This is to certify that the foregoing Registration Statement was received in the office of the State Engineer on the 29th day of July, 19 58, at 8:30 o'clock A.M. and has been duly recorded in said office in Book No. 12 of Registration Statements on page GR 2774

Witness my hand this 25th day of May, 19 59

*Arthur A. Ottenley*  
(State Engineer)

By \_\_\_\_\_ (Deputy)

\$1,500.

GR-2774