

RECEIVED
JUL 29 1953

Registration No. GR - 2957

Certificate No. GR - 2775

Registration Statement

OF CLAIMANT OF RIGHT TO APPROPRIATE GROUND WATER

TO THE STATE ENGINEER OF OREGON:

I, SIEGFRIED B. POMMERENING

of 2595 HOLLYWOOD DRIVE County of MARION
(Mailing address)

State of OREGON, do hereby make application for a certificate of registration as evidence of a right to appropriate ground water.

1. Source from which water is withdrawn is PUMP WELL
(Flowing well, pump well, infiltration trench, or tunnel)

2. Location is: 6 MI. EAST FROM CITY (SALEM) CENTER
(Approximate distance and direction from nearest city or town)

and is more particularly described as follows: Approx 65 Ch SE 63 Ch E from center of Section 18

(a) 80' WEST FROM CENTER OF STREET & 120' SOUTH OF NORTH LINE
(Give distance and bearing to corner of section or other legal subdivision)

being within NW 1/4 OF SE 1/4 of Sec. 18, Twp. 7 S, Rge. 1 W
(Smallest legal subdivision) (N. or S.) (E. or W.)

or (b) within limits of recorded platted property, town or city:

in Lot _____ Block _____ of _____
(Name of plat or addition)

County of _____
(If within city or town, give name)

3. Construction Work was begun on SPRING 1953; was completed on SPRING 1953
(Date) (Date)

and the ground water claimed was first used for the purposes set out below on SUMMER 1953,
(Date)

since which time the water has been used INTERMITTENTLY
(Continuously or intermittently)

from 1953 to PRESENT
(Date) (Date)

4. Quantity of water claimed and used is 35 gallons per minute; 2 acre feet per year.

5. Purpose or Purposes for which water is used IRRIGATION OF PASTURE & GARDEN

(Domestic, irrigation, municipal, manufacturing, industrial, etc.)

6. Description of Well: Depth 75 feet. Type DRILLED
(Dug or drilled)

diameter 6 inches. Elevation of ground at well site _____ feet, mean sea level.
(As near as known)

Depth to water table _____ feet.

7. Capacity of Well: 50 (guess) g.p.m. with _____ feet drawdown.

2 g.p.m. with _____ feet drawdown.

Date of test _____

If Flowing Well: Measured discharge _____ g.p.m. on _____
(Date)

Shut-in pressure at ground surface _____ lbs. per sq. in. on _____
(Date)

Water is controlled by _____
(Cap, valve, etc.)

8. Casing: (Give diameter, commercial specifications and depth below ground surface of each casing size.)

..... inch diameter from to feet
 inch diameter from to feet
 inch diameter from to feet
 inch diameter from to feet

Describe and show depth of shoe, plug, adapter, liner or other details:

9. Perforated Casings or Screens:

Don't know


(Number per foot and size of perforations, or describe screen)

..... from to
 from to
 from to
 from to

10. Log of Well: (Describe each stratum or formation clearly, indicate if water bearing, and give thickness and depth as indicated.)

MATERIAL	Thickness (Feet)	Depth to Bottom (Feet)
<i>NOT AVAILABLE</i>		
<i>NAME OF WELL-DRILLER</i>		
<i>JOHN BECK</i>		
<i>RT. 3, CANBY</i>		
<i>OREGON</i>		

Township 7S Range 1W, W.M.
North

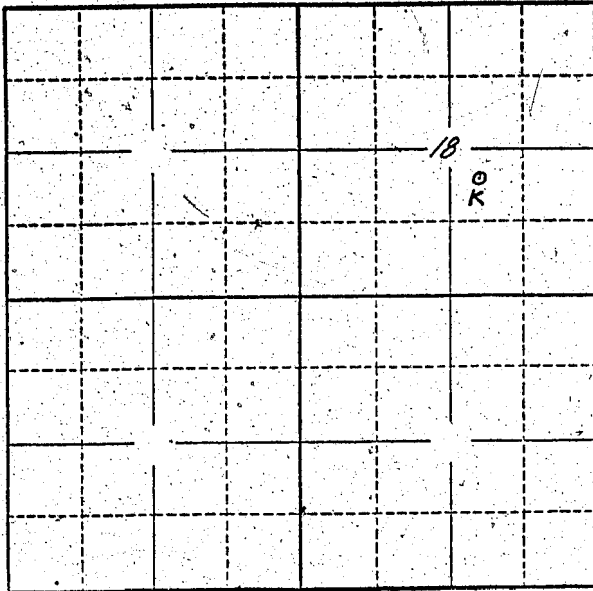

Locate well and acreage of irrigated land on plat.
Scale: 2" = 1 Mile

STATE OF OREGON

County of MARION } ss.


(Signature of Registrant)

Subscribed and sworn to before me this 27th day of July, 1958

My commission expires Oct 25 1961 (Notary Public)

(SEAL)

CERTIFICATE OF REGISTRATION

STATE OF OREGON

County of Marion } ss.

This is to certify that the foregoing Registration Statement was received in the office of the State Engineer on the 29th day of July, 1958, at 9⁰⁰ o'clock A. M. and has been duly recorded in said office in Book No. 12 of Registration Statements on page GR-2775

Witness my hand this 25th day of May, 1959

Laura A. Stanley
(State Engineer)

By _____ (Deputy)

\$15.00

GR - 2775