

Well No. 1  
Upper property

REGISTRATION NO. GR-296

Registration Statement CERTIFICATE NO. GR-276

OF CLAIMANT OF RIGHT TO APPROPRIATE GROUND WATER

(Under Chapter 708, Oregon Laws 1955.)

TO THE STATE ENGINEER OF OREGON:

I, Noble D. Bradley  
of Rte 1 Box 205 Jefferson County of Marion  
State of Oregon, do hereby make application for a certificate of registration as evidence  
of a right to appropriate ground water.

1. Source from which water is withdrawn is Pump well #1  
(Flowing well, pump well, infiltration trench, or tunnel)

2. Location is: 2 miles Southeast of Jefferson  
(Approximate distance and direction from nearest city or town)

and is more particularly described as follows: N 89° 51' W 694.98 ft and N 17° 24' E  
396 ft from S.E. corner of J. Conser D.L.C. No. 63 in

(a) being within SWSE quarter of Sec. 12 Twp. 10 S Rge. 3 W  
(Smallest legal subdivision) (N. or S.) (E. or W.)

or (b) within limits of recorded platted property, town or city:  
in Lot \_\_\_\_\_, Block \_\_\_\_\_ of \_\_\_\_\_  
(Name of plat or addition)  
County of Marion  
(If within city or town, give name)

3. Construction Work was begun on 1953; was completed on 1953  
(Date) (Date)

and the ground water claimed was first used for the purposes set out below on 1953  
since which time the water has been used continuously  
(Continuously or Intermittently)

from 1953 to 1956  
(Date) (Date)

4. Quantity of water claimed and used is 500 gallons per minute; \_\_\_\_\_ acre  
feet per year.

5. Purpose or Purposes for which water is used Irrigation and Mint Distillation  
(Domestic, irrigation, municipal, manufacturing, industrial, etc.)

6. Description of Well: Depth 26 feet. Type Drilled  
(Dug or drilled)  
diameter 10 inches. Elevation of ground at well site 275 feet, mean sea level.  
(As near as known)  
Depth to water table 10 feet.

7. Capacity of Well: 650 g.p.m. with 10 feet drawdown.  
\_\_\_\_\_ g.p.m. with \_\_\_\_\_ feet drawdown.

Date of test \_\_\_\_\_  
If Flowing Well: Measured discharge \_\_\_\_\_ g.p.m. on \_\_\_\_\_  
(Date)  
Shut-in pressure at ground surface \_\_\_\_\_ lbs. per sq. in. on \_\_\_\_\_  
(Date)  
Water is controlled by \_\_\_\_\_  
(Cap, valve, etc.)

8. Casing: (Give diameter, commercial specifications and depth below ground surface of each casing size.)

10 inch diameter Steel casing from 0 to 26 feet  
 inch diameter from to feet  
 inch diameter from to feet  
 inch diameter from to feet

Describe and show depth of shoe, plug, adapter, liner or other details:

9. Perforated Casings or Screens:

1/4 perf. steel casing from 16 to 26  
 (Number per foot and size of perforations, or describe screen)  
 from to  
 from to  
 from to

10. Log of Well: (Describe each stratum or formation clearly, indicate if water bearing, and give thickness and depth as indicated.)

MATERIAL	Thickness (Feet)	Depth to Bottom (Feet)
Dirt	0	6
Sand and silt	6	12
Fine gravel	12	26

Description for Noble D. Bradley Sept. 25, 1956


Beginning at the Southeast corner of the Donation Land Claim of Jacob Conser and wife in Township 10 South, Range 3 West of the Willamette Meridian in Marion County, Oregon; and running thence North 28.55 chains; thence West 10.53 chains; thence South 28.55 chains; thence East 10.53 chains to the place of beginning, being situated in J. Conser D.E.C. in Township 10 South, Range 3 West of the Willamette Meridian in Marion County, State of Oregon. 30.00 acres.

Beginning at a point on the South line of the Jacob Conser Donation Land Claim No. 63 in Township 10 South, Range 3 West of the Willamette Meridian in Marion County, Oregon, which is 1941.68 feet S 89° 51' W from the Southeast corner of said Donation Land Claim; thence N 89° 51' East along the South line of said Donation Land Claim 1246.70 feet to the Southwest corner of a tract of land described in a deed to N.D. Bradley, et ux; by deed recorded April 24, 1943 in Volume 283, Page 173 Marion County, Deed Records; thence North, along the West line of said Bradley tract 1884.25 feet to the Northwest corner of said Bradley tract; thence West 1265.44 feet, more or less, to a point which is N 00° 36' West from the place of beginning; thence South 00° 36' East 1887.40 feet, more or less to the place of beginning, containing 54.00 acres, more or less.

Save and Except 4 acres in the Southeast corner of the above described parcel more particularly described in deed recorded Feb. 4, 1952 in Volume 436, Page 437, Deed Records for Marion County, Oregon.



Township 12 S Range 3 W, W.M.  
North

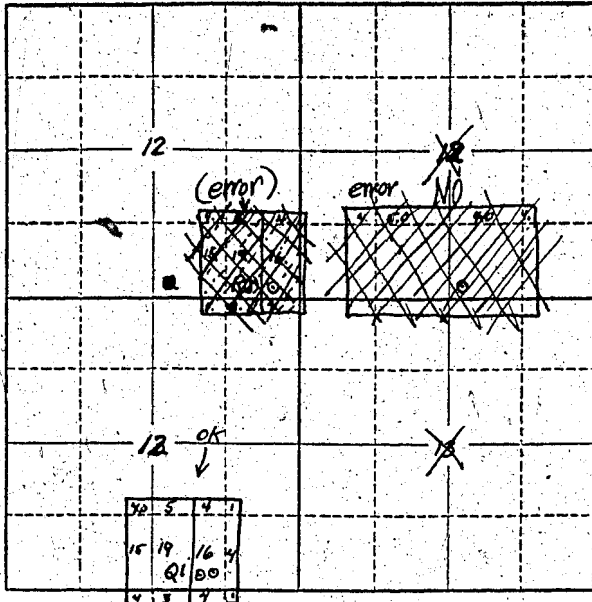

Locate well and acreage of irrigated land on plat.  
Scale: 2" = 1 Mile

STATE OF OREGON

County of Marion } ss.

I, Noble H. Bradley, being first duly sworn, do hereby certify that I have read the foregoing Registration Statement and that all of the items therein contained are true to the best of my knowledge and belief.

Noble H. Bradley  
(Signature of Registrant)

Subscribed and sworn to before me this 15<sup>th</sup> day of November, 1956.

My commission expires January 11, 1958. Ruth V. Ludke  
(Notary Public)

(SEAL)

SEE PAGE GR-276-G FOR  
CERTIFICATE OF REGISTRATION

STATE OF OREGON

County of Marion } ss.

~~This is to certify that the foregoing Registration Statement was received in the office of the State Engineer on this X-X-X-X day of X-X-X-X, 19X-X, and it has been duly recorded in said office in Book No. X-X-X-X of Registration Statements on page X-X-X-X. X-X-X-X Construction shall be completed by X-X-X-X and the water completely applied to the field X-X-X-X by X-X-X-X.~~

Witness my hand this ..... day of ....., 19.....

(State Engineer)

By .....  
(Deputy)

Well No. 2  
Upper property

REGISTRATION NO. GR-296  
CERTIFICATE NO. GR-276

# Registration Statement

## OF CLAIMANT OF RIGHT TO APPROPRIATE GROUND WATER

(Under Chapter 708, Oregon Laws 1955.)

TO THE STATE ENGINEER OF OREGON:

I, Nobel D. Bradley  
of Rte. 1 Box 205 Jefferson County of Marion

State of Oregon, do hereby make application for a certificate of registration as evidence of a right to appropriate ground water.

1. Source from which water is withdrawn is Pump well #2  
(Flowing well, pump well, infiltration trench, or tunnel)

2. Location is: 2 miles Southeast of Jefferson  
(Approximate distance and direction from nearest city or town)

and is more particularly described as follows: N 89° 51' W. 694.98 ft and N 17° 24' E 396 feet and N 75° 38' E 269.65 ft from S.E. Cor. of J. Conser D.L.C. No. 63

(a) S.W.S.E. quarter  
(Give distance and bearing to corner of section or other legal subdivision)

being within S.W.S.E. quarter of Sec. 12, Twp. 10 S, Rge. 3 W  
(Smallest legal subdivision) (N. or S.) (E. or W.)

or (b) within limits of recorded platted property, town or city:

in Lot \_\_\_\_\_, Block \_\_\_\_\_ of \_\_\_\_\_  
(Name of plat or addition)

County of Marion  
(If within city or town, give name)

3. Construction Work was begun on 1942; was completed on 1942  
(Date) (Date)

and the ground water claimed was first used for the purposes set out below on 1942  
(Date)

since which time the water has been used continuously  
(Continuously or Intermittently)

from 1942 to 1956  
(Date) (Date)

4. Quantity of water claimed and used is 500 gallons per minute; \_\_\_\_\_ acre feet per year.

5. Purpose or Purposes for which water is used Irrigation and Mint distillation

(Domestic, irrigation, municipal, manufacturing, industrial, etc.)

6. Description of Well: Depth 22 feet. Type Drilled  
(Dug or drilled)

diameter 6 inches. Elevation of ground at well site 336 275 feet, mean sea level.  
(As near as known)

Depth to water table 10 feet.

7. Capacity of Well: 650 g.p.m. with 10 feet drawdown.

\_\_\_\_\_ g.p.m. with \_\_\_\_\_ feet drawdown.

Date of test \_\_\_\_\_

If Flowing Well: Measured discharge \_\_\_\_\_ g.p.m. on \_\_\_\_\_  
(Date)

Shut-in pressure at ground surface \_\_\_\_\_ lbs. per sq. in. on \_\_\_\_\_  
(Date)

Water is controlled by \_\_\_\_\_  
(Cap, valve, etc.)

GR-276 D





