

Registration Statement

OF CLAIMANT OF RIGHT TO APPROPRIATE GROUND WATER

TO THE STATE ENGINEER OF OREGON:

I, LOUIS J. MERO

of 11811 SE FURBER RD. M.L.W. 22, County of CLACKAMAS

State of OREGON, do hereby make application for a certificate of registration as evidence of a right to appropriate ground water.

1. Source from which water is withdrawn is PUMP WELL
(Flowing well, pump well, infiltration trench, or tunnel)

2. Location is: 3 MILES EAST OF MILWAUKEE
(Approximate distance and direction from nearest city or town)

and is more particularly described as follows:

(a) N 47° 20' 2445 FEET FROM SE CORNER OF SECTION 32
(Give distance and bearing to corner of section or other legal subdivision)

being within NW 1/4 SEX of Sec. 32, Twp. 1S, Rge. 2E
(Smallest legal subdivision) (N. or S.) (E. or W.)

or (b) within limits of recorded platted property, town or city:

in Lot 32, Block 15 of 2E
(Name of plat or addition)

County of Clackamas
(If within city or town, give name)

3. Construction Work was begun on 1923 (Date) (app); was completed on 1923 (Date)

and the ground water claimed was first used for the purposes set out below on 1923 (Date)

since which time the water has been used continuously (uninterrupted)
(Continuously or intermittently)

from 1923 (Date) to ever since 1923 (Date)

4. Quantity of water claimed and used is 30 gallons per minute; 13 acre feet per year.

5. Purpose or Purposes for which water is used irrigation for truck garden

(Domestic, irrigation, municipal, manufacturing, industrial, etc.)

6. Description of Well: Depth 80 feet. Type DRIED
(Dug or drilled)

diameter 6 inches. Elevation of ground at well site 170 feet, mean sea level.
(As near as known)

Depth to water table unk feet.

7. Capacity of Well: g.p.m. with feet drawdown.

..... g.p.m. with feet drawdown.


Date of test 1949 (approx)

If Flowing Well: Measured discharge g.p.m. on (Date)

Shut-in pressure at ground surface lbs. per sq. in. on (Date)

Water is controlled by
(Cap, valve, etc.)

Township 1S Range 2E, W.M.
North

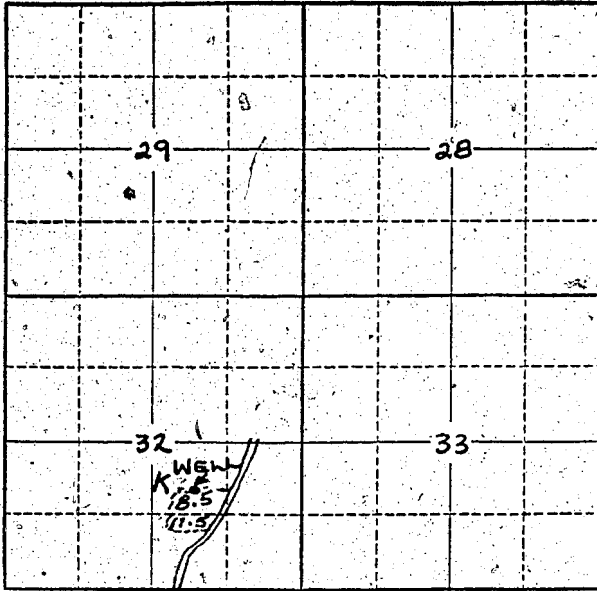

Locate well and acreage of irrigated land on plat.

Scale: 2" = 1 Mile

STATE OF OREGON

County of _____ } ss.

I, Mrs. Julia Merta ^{wife of Louis J. Merta}, being first duly sworn, do hereby certify that I have read the foregoing Registration Statement and that all of the items therein contained are true to the best of my knowledge and belief.

Mrs. Julia Merta
(Signature of Registrant)

Subscribed and sworn to before me this 25 day of July, 1958

My commission expires 8/2/61
(Notary Public)

(SEAL)

CERTIFICATE OF REGISTRATION

STATE OF OREGON

County of Marion } ss.

This is to certify that the foregoing Registration Statement was received in the office of the State Engineer on the 29 day of July, 1958, at 8:00 o'clock A. M. and has been duly recorded in said office in Book No. 12 of Registration Statements on page GR-2894

Witness my hand this 25th day of May, 1959

Lewis A. Stanley
(State Engineer)

By _____
(Deputy)

#15.00

GR-2894