

Registration Statement

OF CLAIMANT OF RIGHT TO APPROPRIATE GROUND WATER

TO THE STATE ENGINEER OF OREGON:

I, RAYMOND F. HILLS

of Route 2, Box 580, Creswell County of Lane

(Mailing address)

State of Oregon, do hereby make application for a certificate of registration as evidence of a right to appropriate ground water.

1. Source from which water is withdrawn is DUMP WELL
(Flowing well, pump well, infiltration trench, or tunnel)

2. Location is: _____
(Approximate distance and direction from nearest city or town)

and is more particularly described as follows:

(a) 1170.1 feet
North 12°20' East to N.E. corner John Shelley DLG # 71
(Give distance and bearing to corner of section or other legal subdivision)

being within SE 1/4 of Sec. 22, Twp. 18 S, Rge. 2 W
(Smallest legal subdivision) (N. or S.) (E. or W.)

or (b) within limits of recorded platted property, town or city: _____

in Lot _____, Block _____ of _____
(Name of plat or addition)

County of Lane
(If within city or town, give name)

3. Construction Work was begun on September, 1948; was completed on September, 1948
(Date) (Date)

and the ground water claimed was first used for the purposes set out below on September, 1948
(Date)

since which time the water has been used continuously
(Continuously or intermittently)

from Sept. 1948 to July 28, 1958
(Date) (Date)

4. Quantity of water claimed and used is 30 gallons per minute; _____ acre feet per year.

5. Purpose or Purposes for which water is used for irrigation of exempt ~~a lawn~~, orchard and ~~some garden and for livestock~~ exempt (< 1/2 acre)
(Domestic, irrigation, municipal, manufacturing, industrial, etc.)

6. Description of Well: Depth 13 feet. Type dug (Dug or drilled)
diameter 10 inches. Elevation of ground at well site 450 feet, mean sea level.
(As near as known)

Depth to water table 2 - 6 feet.

7. Capacity of Well: 30 g.p.m. with no feet drawdown in the spring.

30 g.p.m. with total feet drawdown in late summer

Date of test July 28, 1958

If Flowing Well: Measured discharge _____ g.p.m. on _____
(Date)

Shut-in pressure at ground surface _____ lbs. per sq. in. on _____
(Date)

Water is controlled by _____
(Cap, valve, etc.)

8. Casing: (Give diameter, commercial specifications and depth below ground surface of each casing size.)

10 inch diameter from surface to bottom feet
..... inch diameter from to feet
..... inch diameter from to feet
..... inch diameter from to feet

Describe and show depth of shoe, plug, adapter, liner or other details: a 30 foot trench was dug with a back hoe, and this was lined with 48 inch concrete pipe. From this to the surface runs a 10 inch concrete pipe.

9. Perforated Casings or Screens:

..... from to
(Number per foot and size of perforations, or describe screen)
..... from to
..... from to
..... from to

10. Log of Well: (Describe each stratum or formation clearly, indicate if water bearing, and give thickness and depth as indicated.)

MATERIAL	Thickness (Feet)	Depth to Bottom (Feet)
Top soil	2	---
River-run gravel from soil down to depth unknown		

If log of well is not available, give name and address of driller.....

11. Infiltration Trench: Covered or open EXPOSED.....

Dimensions: Length 30x ft. Minimum depth 13 ft. Maximum depth..... ft.

Bottom width..... ft. Discharge..... g.p.m. Date of test.....

12. Tunnel: Type of lining concrete pipe.....

Dimensions: 30 feet in length of 48 inch concrete pipe running north and south.
(Length, course, and cross sectional size)

Position of water bearing stratum with reference to portal of tunnel below the tunnel.....

Log of tunnel: (Preceding table for log of well may be used, if desired. Give footage from portal and character of materials, as pertinent.)

13. Pumping Equipment:

(Make, type and size)


(b) Motor 3 hp General Electric
(Type and horsepower)

14. Location of area irrigated or to be irrigated, or place of use if for purposes other than irrigation.

Township North or South	Range E. or W. of Williams Meridian	Section	Forty-acre Tract	Number Acres To Be Irrigated	Date of Reclamation
18 S	2 W OF W.M.	22	SE 1/4 of NE 1/4	8.8	Sept., 1948

15. If the ground water supply is supplemental to an existing water supply, identification of any application for a permit, permit, certificate or adjudicated right to appropriate water made or held by the registrant.

Township 18 S Range 2 W W.M.
North

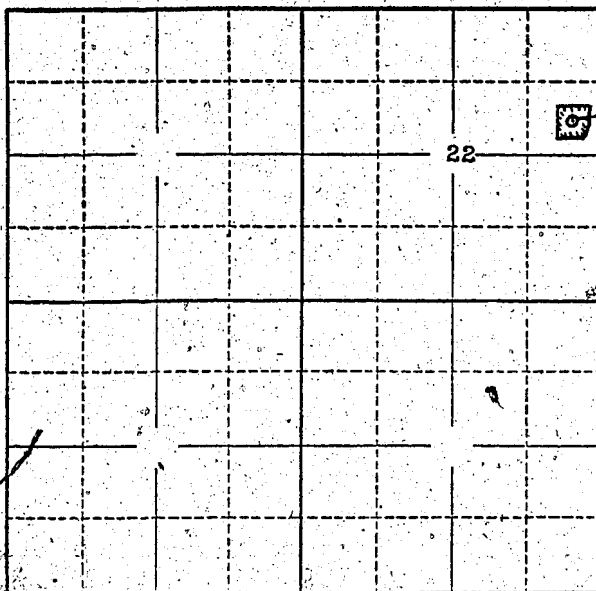

well
approx 8.8 acres

Locate well and acreage of irrigated land on plat.
Scale: 2" = 1 Mile

STATE OF OREGON

County of Lane

ss.

I, RAYMOND F. HILLS, being first duly sworn, do hereby certify that I have read the foregoing Registration Statement and that all of the items therein contained are true to the best of my knowledge and belief.

Raymond F. Hills
(Signature of Registrant)

Subscribed and sworn to before me this 28th day of July, 1958

My commission expires 1-17-61

Marion B. Lawson
(Notary Public)

(SEAL)

CERTIFICATE OF REGISTRATION

STATE OF OREGON

County of Marion

ss.

This is to certify that the foregoing Registration Statement was received in the office of the State Engineer on the 29th day of July, 1958, at 8:00 o'clock A.M. and has been duly recorded in said office in Book No. 12 of Registration Statements on page GR-2784

Witness my hand this 25th day of May, 1959

Lewis A. Stanley
(State Engineer)

By _____
(Deputy)

GR-2784

\$5.00