

# Registration Statement

## OF CLAIMANT OF RIGHT TO APPROPRIATE GROUND WATER

RECEIVED  
JUN 11 1938  
STATE ENGINEER

TO THE STATE ENGINEER OF OREGON:

I, Marvin M. Cornutt  
of 121 River Ave Eugene County of Lane  
(Mailing address)  
State of Oregon, do hereby make application for a certificate of registration as evidence of a right to appropriate ground water.

1. Source from which water is withdrawn is pump well  
(Flowing well, pump well, infiltration trench, or tunnel)

2. Location is: 3 mile north Eugene  
(Approximate distance and direction from nearest city or town)

and is more particularly described as follows: 700 feet South & 300 feet East from NW corner Section 13  
6990.6 ft North 81° East of the N.W. Corner

(a) of Lot A Potters Survey Thence South 17 1/4° West 405 ft.  
(Give distance and bearing to corner of section or other legal subdivision)

being within Potters Survey of Sec. 13, Twp. 17 S, Rge. 4 W  
(Smallest legal subdivision) (N. or S.) (E. or W.)

or (b) within limits of recorded platted property, town or city: Lane Co. Survey #686

in Lot A, Block - of Potters Survey [Stump Town]  
(Name of plat or addition)

County of Lane  
(If within city or town, give name)

3. Construction Work was begun on Approx 5/20/38, was completed on 5/23/38  
(Date) (Date)

and the ground water claimed was first used for the purposes set out below on June 1938  
(Date)

since which time the water has been used Intermittently  
(Continuously or Intermittently)

from Summer months 1938 to Summer months 1958  
(Date) (Date)

4. Quantity of water claimed and used is 4.0 gallons per minute; 5 acre feet per year.

5. Purpose or Purposes for which water is used irrigation

(Domestic, irrigation, municipal, manufacturing, industrial, etc.)

6. Description of Well: Depth 21 feet. Type Driven  
(Dug or drilled)

diameter 2" inches. Elevation of ground at well site 200ft Approx feet, mean sea level.  
(As near as known)

Depth to water table 12 feet.

7. Capacity of Well: 40 g.p.m. with - feet drawdown.

- g.p.m. with - feet drawdown.

Date of test No test

If Flowing Well: Measured discharge - g.p.m. on -  
(Date)


Shut-in pressure at ground surface - lbs. per sq. in. on -  
(Date)

Water is controlled by -  
(Cap, valve, etc.)





Township 17S Range 4W W.M.  
North |

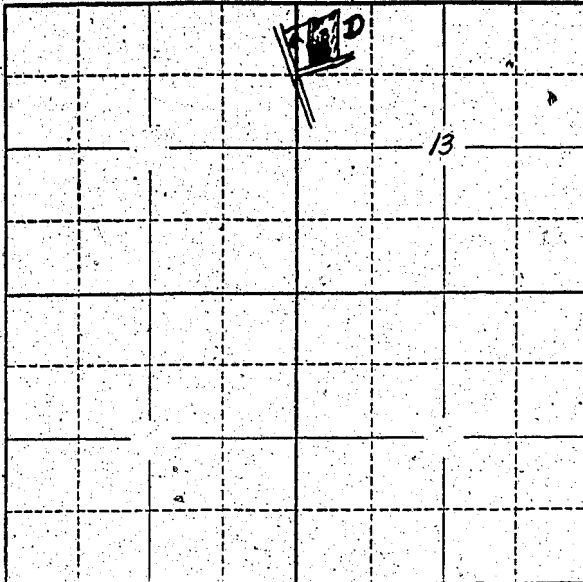

Locate well and acreage of irrigated land on plat.

Scale: 2" = 1 Mile

*all of part B is irrigated except that part which is allotted to*

STATE OF OREGON

County of Lane

ss.

I, Marvin M. Cornutt, being first duly sworn, do hereby certify that I have read the foregoing Registration Statement and that all of the items therein contained are true to the best of my knowledge and belief.

Marvin M. Cornutt  
(Signature of Registrant)

Subscribed and sworn to before me this 28th day of July, 1958

My commission expires

My Commission Expires Aug. 4, 1960

Michael E. Stradley  
(Notary Public)

(SEAL)

**CERTIFICATE OF REGISTRATION**

STATE OF OREGON

County of Marion

ss.

This is to certify that the foregoing Registration Statement was received in the office of the State Engineer on the 29th day of July, 1958, at 8:00 o'clock A. M. and has been duly recorded in said office in Book No. 16 of Registration Statements on page GR 3908

Witness my hand this 15th day of February, 1960.

Lewis A. Stanley  
(State Engineer)

By

(Deputy)

GR 3908

*\$15.00*