Registration No. GR-2972

Certificate No. GR-2786

Registration Statement

OF CLAIMANT OF RIGHT TO APPROPRIATE GROUND WATER

TO THE STATE ENGINEER OF OREGON:

I, Fred T. Moses,

of 4320 Sonoma Rd. Eugene (Mailing address) County of Lane

State of Oregon; do hereby make application for a certificate of registration as evidence of a right to appropriate ground water.

1. **Source** from which water is withdrawn is Pump well (Flowing well, pump well, infiltration trench, or tunnel)

2. **Location** is: 7 Miles North of Eugene (Approximate distance and direction from nearest city or town);

and is more particularly described as follows:

(a) 3951 South of 4th Co. Cemetery Sec 2, T17S, R4W. 330 feet East of West quarter line (Give distance and bearing to corner of section or other legal subdivision)

being within NE NE (Smallest legal subdivision) of Sec. 2, Twp. 17 (N. or S.), Rge. 4 (E. or W.)

or (b) within limits of recorded platted property, town or city:

in Lot, Block of (Name of plat or addition)

(If within city or town, give name) County of

3. **Construction Work** was begun on 1949 (Date); was completed on 1949 (Date)

and the ground water claimed was first used for the purposes set out below on 1949 (Date),

since which time the water has been used Continuously (Continuously or intermittently)

from May (Date) to Sept (Date)

4. **Quantity** of water claimed and used is 7 gallons per minute; 2 acre feet per year.

5. **Purpose or Purposes** for which water is used Irrigation (Domestic, irrigation, municipal, manufacturing, industrial, etc.)

6. **Description of Well:** Depth 7 feet. Type Drilled (Dug or drilled)

diameter 7 1/2 inches. Elevation of ground at well site (As near as known) feet, mean sea level.

Depth to water table 7 feet.

7. **Capacity of Well:** g.p.m. with feet drawdown.

g.p.m. with feet drawdown.

Date of test

If Flowing Well: Measured discharge g.p.m. on (Date)

Shut-in pressure at ground surface lbs. per sq. in. on (Date)

Water is controlled by (Cap, valve, etc.)

8. **Casing:** (Give diameter, commercial specifications and depth below ground surface of each casing size.)

4 1/2 inch diameter ..... from 0 to 44 feet

..... inch diameter ..... from ..... to ..... feet

..... inch diameter ..... from ..... to ..... feet

..... inch diameter ..... from ..... to ..... feet

Describe and show depth of shoe, plug, adapter, liner or other details: .....

9. **Perforated Casings or Screens:**

None ..... from ..... to .....
(Number per foot and size of perforations, or describe screen)

..... from ..... to .....

..... from ..... to .....

..... from ..... to .....

10. **Log of Well:** (Describe each stratum or formation clearly, indicate if water bearing, and give thickness and depth as indicated.)

MATERIAL	Thickness (Feet)	Depth to Bottom (Feet)
None		

GR 2786

If log of well is not available, give name and address of driller. Unknown

11. **Infiltration Trench:** Covered or open .....

Dimensions: Length ..... ft. Minimum depth ..... ft. Maximum depth ..... ft.

Bottom width ..... ft. Discharge ..... g.p.m. Date of test .....

12. **Tunnel:** Type of lining .....

Dimensions: .....
(Length, course, and cross sectional size)

Position of water bearing stratum with reference to portal of tunnel .....

Log of tunnel: (Preceding table for log of well may be used, if desired. Give footage from portal and character of materials, as pertinent.)

13. **Pumping Equipment:**

(a) Pump Cent. ..... Capacity 70 g.p.m.
(Make, type and size)

(b) Motor 5 H.P. Elec.
(Type and horsepower)

14. Location of area irrigated or to be irrigated, or place of use if for purposes other than irrigation.

Township North or South	Range E. or W. of Willamette Meridian	Section	Forty-acre Tract	Number Acres To Be Irrigated	Date of Reclamation
17 S	4 W	7	NE4 NE4	2.0 Ac	1949

15. If the ground water supply is supplemental to an existing water supply, identification of any application for a permit, permit, certificate or adjudicated right to appropriate water made or held by the registrant.

.....

.....

GR 2786

Township 17 S Range 4 W., W.M.

North

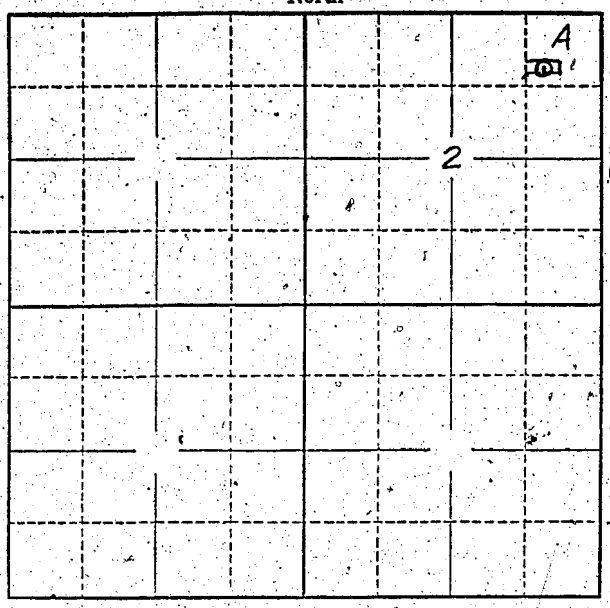

Locate well and acreage of irrigated land on plat.

Scale: 2" = 1 Mile

STATE OF OREGON
County of Lane } ss.

I, Arthur T. Moses, being first duly sworn, do hereby certify that I have read the foregoing Registration Statement and that all of the items therein contained are true to the best of my knowledge and belief.

Arthur T. Moses
(Signature of Registrant)

Subscribed and sworn to before me this 28th day of July 1958

My commission expires July 13, 1960

J. Norman Bunnell
(Notary Public)
State of Oregon

(SEAL)

CERTIFICATE OF REGISTRATION

STATE OF OREGON
County of Marion } ss.

This is to certify that the foregoing Registration Statement was received in the office of the State Engineer on the 29th day of July, 1958, at 8:00 o'clock A M. and has been duly recorded in said office in Book No. 12 of Registration Statements on page GR 2786

Witness my hand this 25th day of May 1959

Lewis A. Stanley
(State Engineer)

By
(Deputy)

$1.50

GR-2786