

# Registration Statement

## OF CLAIMANT OF RIGHT TO APPROPRIATE GROUND WATER

TO THE STATE ENGINEER OF OREGON:

I, Clifton H. Morgan

of 181 Rosetta Ave., Eugene County of Lane

State of Oregon, do hereby make application for a certificate of registration as evidence of a right to appropriate ground water.

1. Source from which water is withdrawn is pump well  
(Flowing well, pump well, infiltration trench, or tunnel)

2. Location is: 7 1/2 miles north of Eugene, Oregon  
(Approximate distance and direction from nearest city or town)

and is more particularly described as follows: 400 feet north & 410 feet east from S 1/4 corner Section 36.

(a) West 178 Feet from center of road. 102 1/2 feet south of north line

being within SW 1/4 + SE 1/4 Tax lot 16 of Sec. 36, Twp. 18 S., Rge. 4 W. Wm  
(Smallest legal subdivision) (N. or S.) (E. or W.)

or (b) within limits of recorded platted property, town or city:

in Lot \_\_\_\_\_, Block \_\_\_\_\_ of \_\_\_\_\_  
(Name of plat or addition)

County of \_\_\_\_\_  
(If within city or town, give name)

3. Construction Work was begun on 1937; was completed on 1937  
(Date) (Date)

and the ground water claimed was first used for the purposes set out below on 20 years ago, more or less  
(Date)

since which time the water has been used as needed for orchard growth  
(Continuously or intermittently)

from 1937 to 1957  
(Date) (Date)

4. Quantity of water claimed and used is 155 gallons per minute; \_\_\_\_\_ acre feet per year.

5. Purpose or Purposes for which water is used to irrigate orchard

(Domestic, irrigation, municipal, manufacturing, industrial, etc.)

6. Description of Well: Depth 23 feet. Type 4 in. driven

diameter 4 inches. Elevation of ground at well site \_\_\_\_\_ feet, mean sea level.  
(Dug or drilled)

Depth to water table 7 feet.  
(As near as known)

7. Capacity of Well: 200 g.p.m. with 2 ft feet drawdown.

\_\_\_\_\_ g.p.m. with \_\_\_\_\_ feet drawdown.

Date of test \_\_\_\_\_

If Flowing Well: Measured discharge \_\_\_\_\_ g.p.m. on \_\_\_\_\_  
(Date)

Shut-in pressure at ground surface \_\_\_\_\_ lbs. per sq. in. on \_\_\_\_\_  
(Date)

Water is controlled by \_\_\_\_\_  
(Cap, valve, etc.)

8. Casing: (Give diameter, commercial specifications and depth below ground surface of each casing size.)

4 inch diameter cast iron casing, from top to 23 feet  
inch diameter from to feet  
inch diameter from to feet  
inch diameter from to feet

Describe and show depth of shoe, plug, adapter, liner or other details:  
.....  
.....

9. Perforated Casings or Screens:

(Number per foot and size of perforations, or describe screen) from to  
from to  
from to  
from to

10. Log of Well: (Describe each stratum or formation clearly, indicate if water bearing, and give thickness and depth as indicated.)

MATERIAL	Thickness (Feet)	Depth to Bottom (Feet)
River loam 12 feet 11 feet gravel	19	23

If log of well is not available, give name and address of driller: .....

11. Infiltration Trench: Covered or open .....

Dimensions: Length ..... ft. Minimum depth ..... ft. Maximum depth ..... ft.

Bottom width ..... ft. Discharge ..... g.p.m. Date of test .....

12. Tunnel: Type of lining .....

Dimensions: ..... (Length, course, and cross-sectional size)

Position of water bearing stratum with reference to portal of tunnel .....

Log of tunnel: (Preceding table for log of well may be used, if desired. Give footage from portal and character of materials, as pertinent.)

13. Pumping Equipment:

(a) Pump Fairbanks Morris Capacity 174 g.p.m. (Make, type and size)


(b) Motor electric 10 horse power (Type and horsepower)

14. Location of area irrigated or to be irrigated, or place of use if for purposes other than irrigation.

Township North or South	Range E. or W. of Willamette Meridian	Section	Forty-acre Tract	Number Acres To Be Irrigated	Date of Reclamation
T 16 S	4W	36	SW 1/4 of SE 1/4	7.24	1937
T 16 S	4W	36	SE 1/4 of SW 1/4	5.00	
				12.24 Ac Total	

15. If the ground water supply is supplemental to an existing water supply, identification of any application for a permit, permit, certificate or adjudicated right to appropriate water made or held by the registrant.

Township 16S ~~17S~~ Range 4W ~~4W~~, W.M.

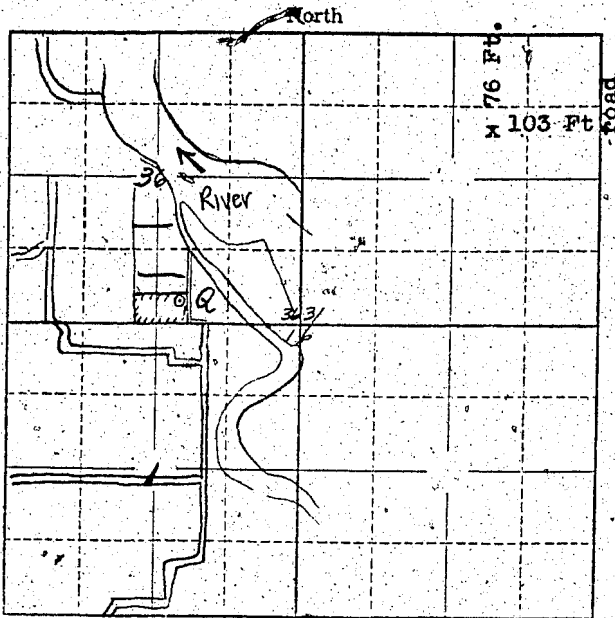

Locate well and acreage of irrigated land on plat.  
Scale: 2" = 1 Mile

STATE OF OREGON

County of Lane } ss.

I, Clifton H. Morgan, being first duly sworn, do hereby certify that I have read the foregoing Registration Statement and that all of the items therein contained are true to the best of my knowledge and belief.

*Clifton H. Morgan*  
(Signature of Registrant)

Subscribed and sworn to before me this \_\_\_\_\_ day of \_\_\_\_\_, 19\_\_\_\_.

My commission expires \_\_\_\_\_

(Notary Public)

(SEAL)

**CERTIFICATE OF REGISTRATION**

STATE OF OREGON

County of Marion } ss.

This is to certify that the foregoing Registration Statement was received in the office of the State Engineer on the 22 day of July, 1960, at 8:00 o'clock A. M. and has been duly recorded in said office in Book No. 17 of Registration Statements on page OR 4061

Witness my hand this 16<sup>th</sup> day of May, 19 60.

\$15.00

*[Signature]*  
(State Engineer)

By \_\_\_\_\_ (Deputy)

GR 4061