

# Registration Statement

## OF CLAIMANT OF RIGHT TO APPROPRIATE GROUND WATER

(Under Chapter 708, Oregon Laws 1955.)

TO THE STATE ENGINEER OF OREGON:

I, Mrs. L. J. Steiger  
of 224 N.E. Steiger St., Grants Pass County of Josephine

State of Oregon, do hereby make application for a certificate of registration as evidence of a right to appropriate ground water.

1. Source from which water is withdrawn is infiltration trench  
(Flowing well, pump well, infiltration trench, or tunnel)

2. Location is: 9 miles southwest of Jacksonville, Oregon  
(Approximate distance and direction from nearest city or town)

and is more particularly described as follows:

(a) 2020 feet south and 950 feet east from NW corner DLC #38  
(Give distance and bearing to corner of section or other legal subdivision)

being within SE, SW, NW of Sec. 28, Twp. 33 S, Rge. 3  
(Smallest legal subdivision) (N. or S.) (E. of W.)

or (b) within limits of recorded platted property, town or city:

in Lot \_\_\_\_\_ Block \_\_\_\_\_ of \_\_\_\_\_  
(Name of plat or addition)

County of \_\_\_\_\_  
(If within city or town, give name)

3. Construction Work was begun on 1930; was completed on 1930  
(Date) (Date)

and the ground water claimed was first used for the purposes set out below on 1930  
(Date)

since which time the water has been used continuously  
(Continuously or intermittently)

from 1930 to present  
(Date) (Date)

4. Quantity of water claimed and used is 140 gallons per minute; 170 acre feet per year.

5. Purpose or Purposes for which water is used irrigation  
(Domestic, irrigation, municipal, manufacturing, industrial, etc.)

6. Description of Sump Depth 17 feet. Type open  
(Dug or drilled)

diameter 30' x 10'. Elevation of ground at well site 1395 feet, mean sea level.  
(As near as known)

Depth to water table 5 feet.

7. Capacity of Well: \_\_\_\_\_ g.p.m. with \_\_\_\_\_ feet drawdown.

\_\_\_\_\_ g.p.m. with \_\_\_\_\_ feet drawdown.

Date of test none

If Flowing Well: Measured discharge \_\_\_\_\_ g.p.m. on \_\_\_\_\_  
(Date)

Shut-in pressure at ground surface \_\_\_\_\_ lbs. per sq. in. on \_\_\_\_\_  
(Date)

Water is controlled by \_\_\_\_\_  
(Cap, valve, etc.)

8. Casing: (Give diameter, commercial specifications and depth below ground surface of each casing size.)

..... inch diameter none from ..... to ..... feet  
..... inch diameter ..... from ..... to ..... feet  
..... inch diameter ..... from ..... to ..... feet  
..... inch diameter ..... from ..... to ..... feet

Describe and show depth of shoe, plug, adapter, liner or other details: .....

9. Perforated Casings or Screens:

..... from ..... to .....  
(Number per foot and size of perforations, or describe screen)  
..... from ..... to .....  
..... from ..... to .....  
..... from ..... to .....

10. Log of Well: (Describe each stratum or formation clearly, indicate if water bearing, and give thickness and depth as indicated.)

MATERIAL	Thickness (Feet)	Depth to Bottom (Feet)
sandy top soil	5	12
medium gravel (water bearing)	12	0

If log of well is not available, give name and address of driller.

11. Infiltration Trench: Covered or open open  
 Dimensions: Length 100 ft. Minimum depth 14 ft. Maximum depth 17 ft.  
 Bottom width 50 ft. Discharge \_\_\_\_\_ g.p.m. Date of test \_\_\_\_\_

12. Tunnel: Type of lining \_\_\_\_\_  
 Dimensions: \_\_\_\_\_  
(Length, course, and cross sectional size)  
 Position of water bearing stratum with reference to portal of tunnel \_\_\_\_\_

Log of tunnel: (Preceding table for log of well may be used, if desired. Give footage from portal and character of materials, as pertinent.)


13. Pumping Equipment:  
 (a) Pump 1.5 inch centrifugal pump (Fairbanks) Capacity 150 g.p.m.  
(Make, type and size)  
 (b) Motor 5.0 H.P. electric motor  
(Type and horsepower)

14. Location of area irrigated or to be irrigated, or place of use if for purposes other than irrigation.

Township North or South	Range E. or W. of Willamette Meridian	Section	Forty-acre Tract	Number Acres To Be Irrigated	Date of Reclamation
38 S.	3 W.	20	SW 1/4	16.2 acres	1950
			SE 1/4	17.2	1950
			NE 1/4	0.1	1950
			N 1/2 NE 1/4 SW 1/4	6.5	1950
			Total	30.0 acres	

15. If the ground water supply is supplemental to an existing water supply, identification of any application for a permit, permit, certificate or adjudicated right to appropriate water made or held by the registrant.  
none

Township 38 S. Range 3 W. W.M. North

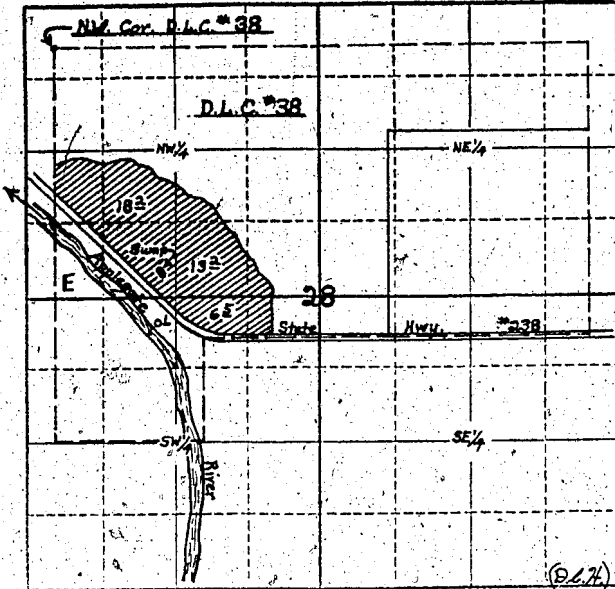

Locate well and acreage of irrigated land on plat.  
Scale: 4" = 1 Mile

STATE OF OREGON

County of Jackson } ss.

I, Russell R. Mee, being first duly sworn, do hereby certify that I have read the foregoing Registration Statement and that all of the items therein contained are true to the best of my knowledge and belief.

*Russell R. Mee*  
(Signature of Registrant)

Subscribed and sworn to before me this 28th day of July, 1958

My commission expires August 25, 1958

*[Signature]*  
(Notary Public)

(SEAL)

CERTIFICATE OF REGISTRATION

STATE OF OREGON } ss.  
County of Marion

This is to certify that the foregoing Registration Statement was received in the office of the State Engineer on the 29th day of July, 1958, at 8:00 o'clock A.M. and has been duly recorded in said office in Book No. 12 of Registration Statements on page GR-2789

~~Construction shall be completed by 10/1/59 and the water completely applied on beneficial use by 10/1/59~~

Witness my hand this 25th day of May, 1959

*Lewis A. Stanley*  
(State Engineer)

By \_\_\_\_\_ (Deputy)

GR-2789

#16.20