

RECEIVED

NOV 15 1956

STATE ENGINEER  
SALEM, OREGON

REGISTRATION NO. GR-298

Registration Statement (CERTIFICATE NO. GR-278)

8AM

OF CLAIMANT OF RIGHT TO APPROPRIATE GROUND WATER

(Under Chapter 708, Oregon Laws 1955.)

TO THE STATE ENGINEER OF OREGON:

I, Jack Brandis John S. Brandis

of Corvallis County of Benton

State of Oregon, do hereby make application for a certificate of registration as evidence of a right to appropriate ground water.

1. Source from which water is withdrawn is pump well

(Flowing well, pump well, infiltration trench, or tunnel)

2. Location is: 1 mile N. of Corvallis

(Approximate distance and direction from nearest city or town)

and is more particularly described as follows:

(a) 379' N. and 35' W. of SW cor. Heman C. Lewis D.L.C. #47, T. 11S, R. 5W

(Give distance and bearing to corner of section or other legal subdivision)

being within NW1/4 of NW1/4 of Sec. 26, Twp. 11S, Rge. 5W

(Smallest legal subdivision)

(N. or S.)

(E. or W.)

or (b) within limits of recorded platted property, town or city:

in Lot \_\_\_\_\_, Block \_\_\_\_\_ of \_\_\_\_\_

(Name of plat or addition)

County of \_\_\_\_\_

(If within city or town, give name)

3. Construction Work was begun on 1953; was completed on 1953

(Date)

(Date)

and the ground water claimed was first used for the purposes set out below on 1953

(Date)

since which time the water has been used continuously

(Continuously or intermittently)

from 1953 to 1956

(Date)

(Date)

4. Quantity of water claimed and used is 300 gallons per minute; 210 acre feet per year.

5. Purpose or Purposes for which water is used irrigation

(Domestic, irrigation, municipal, manufacturing, industrial, etc.)

6. Description of Well: Depth 55 feet. Type drilled

(Dug or drilled)

diameter 10 inches. Elevation of ground at well site 250 feet, mean sea level.

(As near as known)

Depth to water table 38 feet.

7. Capacity of Well: unknown g.p.m. with \_\_\_\_\_ feet drawdown.

\_\_\_\_\_ g.p.m. with \_\_\_\_\_ feet drawdown.

Date of test \_\_\_\_\_

If Flowing Well: Measured discharge \_\_\_\_\_ g.p.m. on \_\_\_\_\_

(Date)

Shut-in pressure at ground surface \_\_\_\_\_ lbs. per sq. in. on \_\_\_\_\_

(Date)

Water is controlled by \_\_\_\_\_

(Cap, valve, etc.)

8. Casing: (Give diameter, commercial specifications and depth below ground surface of each casing size.)

10 inch diameter ..... from 0 to 50 feet  
..... inch diameter ..... from ..... to ..... feet  
..... inch diameter ..... from ..... to ..... feet  
..... inch diameter ..... from ..... to ..... feet

Describe and show depth of shoe, plug, adapter, liner or other details: unknown

9. Perforated Casings or Screens:

unknown ..... from ..... to .....  
(Number per foot and size of perforations, or describe screen)  
..... from ..... to .....  
..... from ..... to .....  
..... from ..... to .....

10. Log of Well: (Describe each stratum or formation clearly, indicate if water bearing, and give thickness and depth as indicated.)

MATERIAL	Thickness (Feet)	Depth to Bottom (Feet)
<u>unknown</u>		

If log of well is not available, give name and address of driller.

Schaffer of Independence, Ore. (now believed to be in eastern Oregon)

11. Infiltration Trench: Covered or open

Dimensions: Length ft. Minimum depth ft. Maximum depth ft.

Bottom width ft. Discharge g.p.m. Date of test

12. Tunnel: Type of lining

Dimensions: (Length, course, and cross sectional size)

Position of water bearing stratum with reference to portal of tunnel

Log of tunnel: (Preceding table for log of well may be used, if desired. Give footage from portal and character of materials, as pertinent.)

13. Pumping Equipment:

(a) Pump 4 stage turbine, Berkeley Capacity 600+ g.p.m. (Make, type and size)

(b) Motor 25hp. Electric (Type and horsepower)


14. Location of area irrigated or to be irrigated, or place of use if for purposes other than irrigation.

Township North or South	Range E. or W. of Willamette Meridian	Section	Forty-acre Tract	Number Acres To Be Irrigated	Date of Reclamation
11S	5W	27	NE of NE	31.5	1953
"	"	"	" " "	3.6	1955 (July)
"	"	"	SE of NE	2.04	1953
"	"	"	" " "	0.44	1955 (July)
"	"	"	SW of NE	0.76	1953
"	"	"	NW of NE	6.6	1953
"	"	26	NW of NW	16.9	1953
"	"	"	" " "	15.1	1955 (July)
"	"	"	SW of NW	1.84	1955 (July)

15. If the ground water supply is supplemental to an existing water supply, identification of any application for a permit, permit, certificate or adjudicated right to appropriate water made or held by the registrant.

none

Township 11S Range 5W W.M.  
North

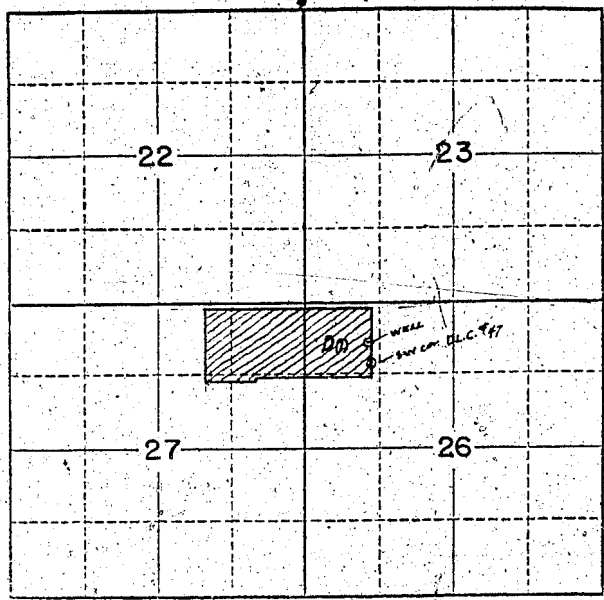

Locate well and acreage of irrigated land on plat.  
Scale: 2" = 1 Mile

STATE OF OREGON }  
County of Benton } ss.

I, John S. Brandis, being first duly sworn, do hereby certify that I have read the foregoing Registration Statement and that all of the items therein contained are true to the best of my knowledge and belief.

*John S. Brandis*  
(Signature of Registrant)

Subscribed and sworn to before me this 14th day of November, 1956.

My commission expires \_\_\_\_\_  
NOTARY PUBLIC FOR OREGON  
(SEAL) MY COMMISSION EXPIRES DEC. 28, 1958

*Walter J. Stone*  
(Notary Public)

**CERTIFICATE OF REGISTRATION**

STATE OF OREGON }  
County of Marion } ss.

This is to certify that the foregoing Registration Statement was received in the office of the State Engineer on the 19th day of November, 1956, at \_\_\_\_\_ o'clock A.M. and has been duly recorded in said office in Book No. 2 of Registration Statements on page GR-278-C.

~~Concession shall be completed by \_\_\_\_\_ and the system completed as applied to benefit \_\_\_\_\_ by \_\_\_\_\_~~

Witness my hand this 15th day of January, 1957.

*Leuris A. Stanley*  
(State Engineer)

By \_\_\_\_\_  
(Deputy)

GR-278C