

Registration Statement

OF CLAIMANT OF RIGHT TO APPROPRIATE GROUND WATER

TO THE STATE ENGINEER OF OREGON:

I, Kenneth Goebel
of 882 Hopkins Road, Central Point, County of Jackson
(Mailing address)

State of Oregon, do hereby make application for a certificate of registration as evidence of a right to appropriate ground water.

1. Source from which water is withdrawn is infiltration trench (Sump) #2
(Flowing well, pump well, infiltration trench, or tunnel)

2. Location is: 1/2 mile southeast of Central Point, Oregon
(Approximate distance and direction from nearest city or town)

and is more particularly described as follows:

(a) 716 feet South and 375 feet East from the NW Corner DLC #58
(Give distance and bearing to corner of section or other legal subdivision)

being within SW 1/4 NE 1/4 of Sec. 11, Twp. 37 S., Rge. 2 W.
(Smallest legal subdivision) (N. or S.) (E. or W.)

or (b) within limits of recorded platted property, town or city:

in Lot 11, 12 & Block 13 of Pitt View
(Name of plat or addition)

County of Jackson
(If within city or town, give name)

3. Construction Work was begun on 1933; was completed on 1933
(Date) (Date)

and the ground water claimed was first used for the purposes set out below on 1933
(Date)

since which time the water has been used intermittently
(Continuously or intermittently)

from 1933 to summer 1957
(Date) (Date)

4. Quantity of water claimed and used is 70 gallons per minute; 56 acre feet per year.

5. Purpose or Purposes for which water is used irrigation

(Domestic, irrigation, municipal, manufacturing, industrial, etc.)

6. Description of Well: Depth 20 feet. Type dug
(Dug or drilled)

top - 3'x20'x60' bottom diameter 10'x10' inches. Elevation of ground at well site 1300 feet, mean sea level.
(As near as known)

Depth to water, table 7.0 feet. at present date (July -1958)

7. Capacity of Well: _____ g.p.m. with _____ feet drawdown.

_____ g.p.m. with _____ feet drawdown.


Date of test none

If Flowing Well: Measured discharge _____ g.p.m. on _____
(Date)

Shut-in pressure at ground surface _____ lbs. per sq. in. on _____
(Date)

Water is controlled by _____
(Cap, valve, etc.)

Township 37S Range 2W W.M. North

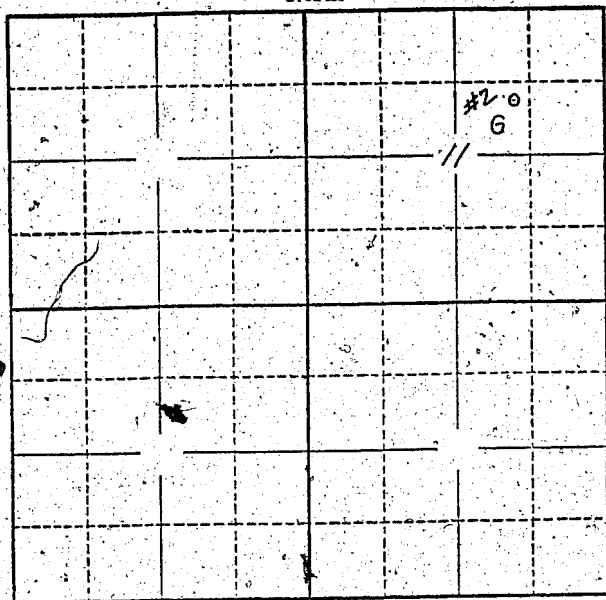

Locate well and acreage of irrigated land on plat.
Scale: 2" = 1 Mile

STATE OF OREGON

County of Jackson } ss.

I, Kenneth Goebel, being first duly sworn, do hereby certify that I have read the foregoing Registration Statement and that all of the items therein contained are true to the best of my knowledge and belief.

Kenneth Goebel
(Signature of Registrant)

Subscribed and sworn to before me this 28th day of July, 1958.

My commission expires August 25, 1958

High [Signature]
(Notary Public)

(SEAL)

CERTIFICATE OF REGISTRATION

STATE OF OREGON

County of Marion } ss.

This is to certify that the foregoing Registration Statement was received in the office of the State Engineer on the 29 day of July, 1958, at 8:00 o'clock A. M. and has been duly recorded in said office in Book No. 12 of Registration Statements on page GR-2791

Witness my hand this 25th day of May, 1959

Lewis A. Stanley
(State Engineer)

By _____ (Deputy)

#15.00