

Well #1

Registration No. GR-2981

Certificate No. GR-2792

Registration Statement

OF CLAIMANT OF RIGHT TO APPROPRIATE GROUND WATER

TO THE STATE ENGINEER OF OREGON:

I, Nicholas Olheiser
of Rt. 3 Box 502 Corvallis County of Benton
(Mailing address)

State of OREGON, do hereby make application for a certificate of registration as evidence of a right to appropriate ground water.

- 1. Source from which water is withdrawn is PUMP Well #1
(Flowing well, pump well, infiltration trench, or tunnel)
- 2. Location is: 5 Miles S.W. FROM CORVALLIS
(Approximate distance and direction from nearest city or town)

and is more particularly described as follows:

(a) East Well #1 lies 1221' West 798' N of SE Corner Sec. 21
(Give distance and bearing to corner of section or other legal subdivision)

being within SE 1/4 SE 1/4 of Sec. 21, Twp. 12 S, Rge. 5 W
(Smallest legal subdivision) (N. or S.) (E. or W.)

or (b) within limits of recorded platted property, town or city:

in Lot _____, Block _____ of _____
(Name of plat or addition)
County of _____
(If within city or town, give name)

3. Construction Work was begun on Aug 1, 1949; was completed on AUG. 10
(Date) (Date)

and the ground water claimed was first used for the purposes set out below on AUG. 15, 1949
(Date)

since which time the water has been used CONTINUOUSLY
(Continuously or Intermittently)

from Aug 15, 1949 to SEPT. 15, 1949
(Date) (Date)

4. Quantity of water claimed and used is 80 gallons per minute; 80 acre feet per year.

5. Purpose or Purposes for which water is used _____

IRRIGATION
(Domestic, irrigation, municipal, manufacturing, industrial, etc.)

6. Description of Well: Depth 65 feet. Type Drilled
(Dug or drilled)

diameter 10 inches: Elevation of ground at well site 290 feet, mean sea level.
(As near as known)

Depth to water table 4.2 feet.

7. Capacity of Well: 80 g.p.m. with 23 feet drawdown.

_____ g.p.m. with _____ feet drawdown.

Date of test _____

If Flowing Well: Measured discharge _____ g.p.m. on _____
(Date)


Shut-in pressure at ground surface _____ lbs. per sq. in. on _____
(Date)

Water is controlled by _____
(Cap, valve, etc.)

* West Well (#2) lies 366' west of East Well (#1)

Township 12S Range 5W, W.M.

North

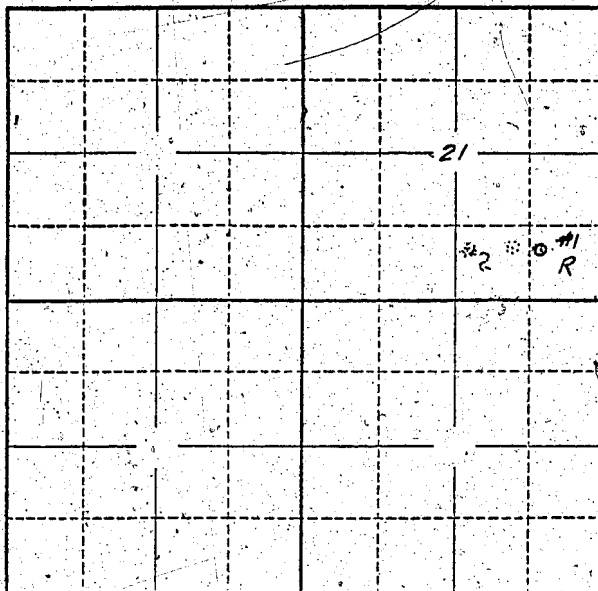

Locate well and acreage of irrigated land on plat.
Scale: 2" = 1 Mile

STATE OF OREGON


I, Nicholas Olheiser, being first duly sworn, do hereby certify that I have read the foregoing Registration Statement and that all of the items therein contained are true to the best of my knowledge and belief.

Nicholas Olheiser
(Signature of Registrant)

Subscribed and sworn to before me this 28th day of July, 1958

My commission expires 1/4/58 Scott Williams
(Notary Public)

(SEAL)

CERTIFICATE OF REGISTRATION

STATE OF OREGON

County of Marion } ss.

This is to certify that the foregoing Registration Statement was received in the office of the State Engineer on the 29 day of July, 1958, at 8:00 o'clock A. M. and has been duly recorded in said office in Book No. 12 of Registration Statements on page GR-2792

Witness my hand this 25th day of May, 1959

Lewis A. Stanley
(State Engineer)

By _____
(Deputy)

#16.00