

# Registration Statement

## OF CLAIMANT OF RIGHT TO APPROPRIATE GROUND WATER

TO THE STATE ENGINEER OF OREGON:

I, Raymond L. and Elinor Meyer

of Rt. 1, Box 310, Albany County of Linn

State of Oregon

, do hereby make application for a certificate of registration as evidence of a right to appropriate ground water.

1. Source from which water is withdrawn is Pump Well No. 1  
(Flowing well, pump well, infiltration trench, or tunnel)

2. Location is: 3 1/2 miles SW of Crabtree, Oregon  
(Approximate distance and direction from nearest city or town)

and is more particularly described as follows:

(a) 2772' N. and 1000' E. of SW corner S. 15, T. 11 S., R. 2 W  
(Give distance and bearing to corner of section or other legal subdivision)

being within SE 1/4 of NW 1/4 of Sec. 15, Twp. 11 S, Rge. 2 W  
(Smallest legal subdivision) (N. or S.) (E. or W.)

or (b) within limits of recorded platted property, town or city:

in Lot \_\_\_\_\_, Block \_\_\_\_\_ of \_\_\_\_\_  
(Name of plat or addition)

County of Linn  
(If within city or town, give name)

3. Construction Work was begun on May 11, 1949; was completed on May 15, 1959  
(Date) (Date)

and the ground water claimed was first used for the purposes set out below on May 20, 1949  
(Date)

since which time the water has been used continuously  
(Continuously or Intermittently)

from May 20, 1949 to present time  
(Date) (Date)

4. Quantity of water claimed and used is 200 gallons per minute; 102 acre feet per year.

5. Purpose or Purposes for which water is used Irrigation

(Domestic, irrigation, municipal, manufacturing, industrial, etc.)

6. Description of Well: Depth 27 feet. Type Drilled

(Dug or drilled)

diameter 10 inches. Elevation of ground at well site 192 feet, mean sea level.  
(As near as known)

Depth to water table 8 feet.

7. Capacity of Well: 600 g.p.m. with 9 feet drawdown.

\_\_\_\_\_ g.p.m. with \_\_\_\_\_ feet drawdown.

Date of test May 15, 1949

If Flowing Well: Measured discharge \_\_\_\_\_ g.p.m. on \_\_\_\_\_  
(Date)

Shut-in pressure at ground surface \_\_\_\_\_ lbs. per sq. in. on \_\_\_\_\_  
(Date)

Water is controlled by \_\_\_\_\_  
(Cap, valve, etc.)

8. Casing: (Give diameter, commercial specifications and depth below ground surface of each casing size.)

10 inch diameter steel casing from 0 to 26' 9" feet  
inch diameter from to feet  
inch diameter from to feet  
inch diameter from to feet

Describe and show depth of shoe, plug, adapter, liner or other details:

9. Perforated Casings or Screens:

Slot perforations from 17' to 26'  
(Number per foot and size of perforations, or describe screen)  
from to  
from to  
from to

10. Log of Well: (Describe each stratum or formation clearly, indicate if water bearing, and give thickness and depth as indicated.)

MATERIAL	Thickness (Feet)	Depth to Bottom (Feet)
Not available		

If log of well is not available, give name and address of driller. Bill Hamilton Drilling Co.,  
838 E. Third Ave., Albany, Oregon

11. Infiltration Trench: Covered or open .....  
 Dimensions: Length ..... ft. Minimum depth ..... ft. Maximum depth ..... ft.  
 Bottom width ..... ft. Discharge ..... g.p.m. Date of test .....

12. Tunnel: Type of lining .....  
 Dimensions: .....  
(Length, course, and cross sectional size)  
 Position of water bearing stratum with reference to portal of tunnel .....

Log of tunnel: (Preceding table for log of well may be used, if desired. Give footage from portal and character of materials, as pertinent.)


13. Pumping Equipment:  
 (a) Pump 2" centrifugal ..... Capacity 250 g.p.m.  
(Make, type and size)  
 (b) Motor 10 H. P. electric .....  
(Type and horsepower)

14. Location of area irrigated or to be irrigated, or place of use if for purposes other than irrigation.

Township North or South	Range E. or W. of Willamette Meridian	Section	Forty-acre Tract	Number Acres To Be Irrigated	Date of Reclamation
11 S	2 W	15	SW $\frac{1}{4}$ of NW $\frac{1}{4}$	13.5	May 20, 1949
11 S	2 W	15	SE $\frac{1}{4}$ of NW $\frac{1}{4}$	16.5	May 20, 1949
11 S	2 W	15	SW $\frac{1}{4}$ of NE $\frac{1}{4}$	4.0	May 20, 1949
				34.0	

15. If the ground water supply is supplemental to an existing water supply, identification of any application for a permit, permit, certificate or adjudicated right to appropriate water made or held by the registrant.  
 .....  
 .....

Township 11 S Range 2 W, W.M.  
North

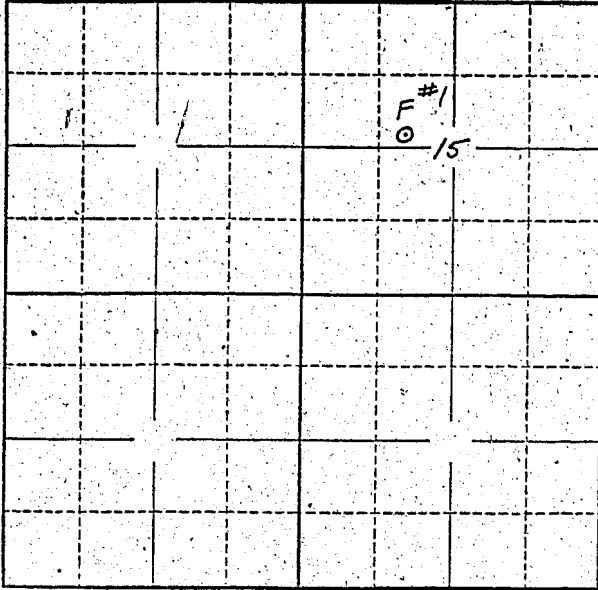

Locate well and acreage of irrigated land on plat.  
Scale: 2" = 1 Mile

STATE OF OREGON  
County of LINN } ss.

I, Raymond L. and Elinor Meyer, being first duly sworn, do hereby certify that I have read the foregoing Registration Statement and that all of the items therein contained are true to the best of my knowledge and belief.

*Raymond L. Meyer*  
*Elinor Meyer*  
(Signature of Registrant)

Subscribed and sworn to before me this 28 day of Nov, 1958

My commission expires \_\_\_\_\_  
My Commission Expires June 21, 1960  
(SEAL) *F. H. Alexander*  
(Notary Public)

**CERTIFICATE OF REGISTRATION**

STATE OF OREGON } ss.  
County of Marion

This is to certify that the foregoing Registration Statement was received in the office of the State Engineer on the 29 day of July, 1958, at 5:00 o'clock A. M. and has been duly recorded in said office in Book No. 12 of Registration Statements on page GR-2796

Witness my hand this 25<sup>th</sup> day of May, 1959

*Lewis A. Stanley*  
(State Engineer)

By \_\_\_\_\_  
(Deputy)

\$15.60