

Registration Statement

OF CLAIMANT OF RIGHT TO APPROPRIATE GROUND WATER

(Under Chapter 708, Oregon Laws 1955.)

TO THE STATE ENGINEER OF OREGON:

I, Oregon State College
of Corvallis, Oregon County of Benton

State of Oregon, do hereby make application for a certificate of registration as evidence of a right to appropriate ground water.

1. Source from which water is withdrawn is pump well
(Flowing well, pump well, infiltration trench, or tunnel)
2. Location is: 1/2 E, 1/2 N Corvallis, Oregon
(Approximate distance and direction from nearest city or town)

and is more particularly described as follows:

(a) 3322' W, 1368' N of N.W. Cor. Pleasant Robinett D.L.C. 71
(Give distance and bearing to corner of section or other legal subdivision)

being within NW 1/4 of SW 1/4 of Sec. 36, Twp. 11S, Rge. 5W
(Smallest legal subdivision) (N. or S.) (E. or W.)

or (b) within limits of recorded platted property, town or city:

in Lot _____, Block _____ of _____
(Name of plat or addition)
County of _____
(If within city or town, give name)

3. Construction Work was begun on _____; was completed on July 18, 1955
(Date)

and the ground water claimed was first used for the purposes set out below on July 25, 1955
(Date)

since which time the water has been used continuously
(Continuously or Intermittently)

from July 1955 to present
(Date) (Date)

4. Quantity of water claimed and used is 350 gallons per minute; 200 acre feet per year.

5. Purpose or Purposes for which water is used irrigation

(Domestic, irrigation, municipal, manufacturing, industrial, etc.)

6. Description of Well: Depth 31 feet. Type drilled
(Dug or drilled)

diameter 8 inches. Elevation of ground at well site 220 approx. feet, mean sea level.
(As near as known)

Depth to water table 17 feet.

7. Capacity of Well: 560 g.p.m. with 5 feet drawdown.

300 g.p.m. with 3 feet drawdown.


Date of test 7-25-55

If Flowing Well: Measured discharge _____ g.p.m. on _____
(Date)

Shut-in pressure at ground surface _____ lbs. per sq. in. on _____
(Date)

Water is controlled by _____
(Cap, valve, etc.)

Township 11 S Range 5 W W.M.
North

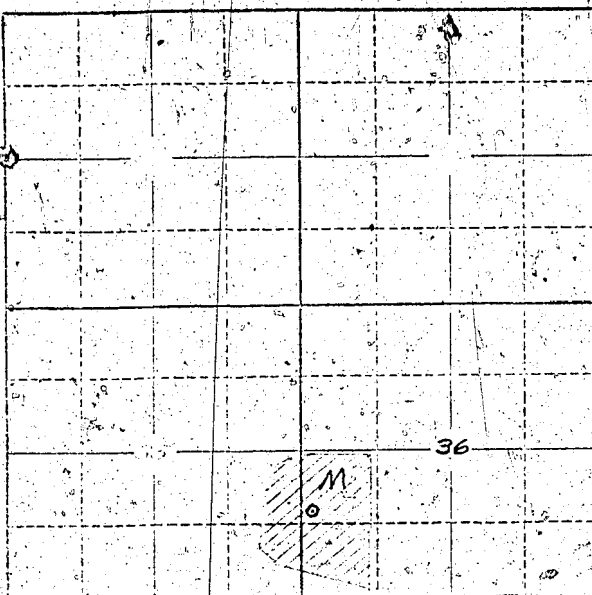

Locate well and acreage of irrigated land on plat.
Scale: 2" = 1 Mile

STATE OF OREGON

County of Benton

ss.

I, G. Morris Robertson, being first duly sworn, do hereby certify that I have read the foregoing Registration Statement and that all of the items therein contained are true to the best of my knowledge and belief.

[Signature]
Business Manager (Signature of Registrar) State College

Subscribed and sworn to before me this 18 day of July, 1958

My commission expires 4 Nov 1960

(Notary Public)

(SEAL)

CERTIFICATE OF REGISTRATION

STATE OF OREGON

County of Marion

ss.

This is to certify that the foregoing Registration Statement was received in the office of the State Engineer on the 24th day of July, 1958, at 8:00 o'clock A. M. and has been duly recorded in said office in Book No. 16 of Registration Statements on page 3798

~~Construction shall be completed by 1959 and the water completed by 1960~~
~~and the water shall be completed by 1960~~

Witness my hand this 20th day of November, 1959

[Signature]
(State Engineer)

By

(Deputy)

GR-3798

\$ 24.60