RECEIVED
NOV 16 1956
STATE ENGINEER
SALEM, OREGON

REGISTRATION NO. GR-299
CERTIFICATE NO. GR-279

Registration Statement

OF CLAIMANT OF RIGHT TO APPROPRIATE GROUND WATER

(Under Chapter 708, Oregon Laws 1955.)

TO THE STATE ENGINEER OF OREGON:

I, Rose M. Grenz

of Rt. 2, Box 428 A, Albany County of Linn

State of Oregon, do hereby make application for a certificate of registration as evidence of a right to appropriate ground water.

1. **Source** from which water is withdrawn is Pump Well No. 1 (Flowing well, pump well, infiltration trench, or tunnel)

2. **Location is:** ½ mile west of Jefferson, Oregon (Approximate distance and direction from nearest city or town)

and is more particularly described as follows:

(a) N. 9° 07' W. 11.46 chains from the SW corner of SE¼ of S. 11, T. 10 S., R. 3 W.W.M. (Give distance and bearing to corner of section or other legal subdivision)

being within SE¼ of SW¼ (Smallest legal subdivision) of Sec. 11, Twp. 10 S (N. or S.), Rge. 3 W. (E. or W.)

or (b) within limits of recorded platted property, town or city:

in Lot ....., Block ..... of ..... (Name of plat or addition)

..... (If within city or town, give name) County of Linn

3. **Construction Work** was begun on June 10, 1942 (Date); was completed on June 14, 1942 (Date)

and the ground water claimed was first used for the purposes set out below on June 18, 1942 (Date),

since which time the water has been used continuously (Continuously or intermittently)

from June 18, 1942 (Date) to present time (Date)

4. **Quantity** of water claimed and used is 320 gallons per minute; 197 acre feet per year.

5. **Purpose or Purposes** for which water is used Irrigation

..... (Domestic, irrigation, municipal, manufacturing, industrial, etc.)

6. **Description of Well:** Depth 23 feet. Type drilled (Dug or drilled)

diameter 4 inches. Elevation of ground at well site 215 (As near as known) feet, mean sea level.

Depth to water table 10 feet.

7. **Capacity of Well:** 350 g.p.m. with 6 feet drawdown.

..... g.p.m. with ..... feet drawdown.

Date of test Not tested

If Flowing Well: Measured discharge ..... g.p.m. on ..... (Date)

Shut-in pressure at ground surface ..... lbs. per sq. in. on ..... (Date)

Water is controlled by ..... (Cap, valve, etc.)

8. **Casing:** (Give diameter, commercial specifications and depth below ground surface of each casing size.)

4 inch diameter Steel casing from 0 to 23 feet

..... inch diameter ..... from ..... to ..... feet

..... inch diameter ..... from ..... to ..... feet

..... inch diameter ..... from ..... to ..... feet

Describe and show depth of shoe, plug, adapter, liner or other details: .....

9. **Perforated Casings or Screens:**

Slit perforations from 15' to 23'
(Number per foot and size of perforations, or describe screen)

..... from ..... to .....

..... from ..... to .....

..... from ..... to .....

10. **Log of Well:** (Describe each stratum or formation clearly, indicate if water bearing, and give thickness and depth as indicated.)

MATERIAL	Thickness (Feet)	Depth to Bottom (Feet)
Not available		

GR-279 A

If log of well is not available, give name and address of driller. Weymore Well Drillers & Contractors Rt.2, Box 317, Salem, Oregon

11. **Infiltration Trench:** Covered or open .....

Dimensions: Length ..... ft. Minimum depth ..... ft. Maximum depth ..... ft.

Bottom width ..... ft. Discharge ..... g.p.m. Date of test .....

12. **Tunnel:** Type of lining .....

Dimensions: .....
(Length, course, and cross sectional size)

Position of water bearing stratum with reference to portal of tunnel .....

Log of tunnel: (Preceding table for log of well may be used, if desired. Give footage from portal and character of materials, as pertinent.)

13. **Pumping Equipment:**

(a) Pump Gardner Denver Type B 2" centrifugal ..... Capacity 320 ..... g.p.m.
(Make, type and size)

(b) Motor 15 H.P. electric .....
(Type and horsepower)

14. Location of area irrigated or to be irrigated, or place of use if for purposes other than irrigation.

Township North or South	Range E. or W. of Willamette Meridian	Section	Forty-acre Tract	Number Acres To Be Irrigated	Date of Reclamation
10 S	3 W	11	NE¼ of SW¼	2.0	June 18, 1942
10 S	3 W	11	S E½ of SW¼	4.4	"
10 S	3 W	11	NW¼ of SE¼	6.2	"
10 S	3 W	11	SW¼ of SE¼	7.0	"
				19.6	

153-54

Beginning at a 3/4"x24" iron pipe which is North 11.140 chains and West 15.395 chains from the Southeast corner of the Jacob L. Miller D.L.C. 61 in T. 10 S., R 3 W. of the Will. Mer. in Linn Co., Oregon; and running thence N. 30°19½' W. 12.728 chains to a 1"x31" Ford radius rod on the Southerly right of way line of the Southern Pacific Railroad; thence along said railroad line N. 65° 50' E. 11.452 chains N. 68°05½' E. 19.488 chains N. 70°21'E. 3.272 chains to the Santiam River; thence S. 10°10' W. along the Westerly side of said river 14.025 chains to a point from which a ½" iorn pipe bears S. 65°44' W. 2.250 chains; thence S. 65°44' W. 24.921 chains to the place of beginning, containing 36.7 acres Save and Except therefrom the heretofore granted to the Southern Pacific Railroad Co. to construct breakwater to protect bridges, Also a strip 8 ft. wide along West line for road purposes.

15. If the ground water supply is supplemental to an existing water supply, identification of any application for a permit, permit, certificate or adjudicated right to appropriate water made or held by the registrant: .....

GR-279B

Township 10 S Range 3 W, W.M.

North

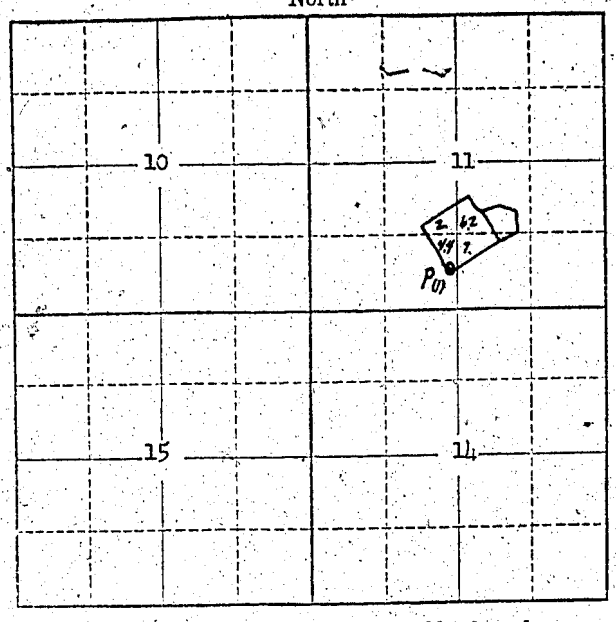

Locate well and acreage of irrigated land on plat.

Scale: 2" = 1 Mile

STATE OF OREGON
County of Linn } ss.

I, Rose M. Grenz, being first duly sworn, do hereby certify that I have read the foregoing Registration Statement and that all of the items therein contained are true to the best of my knowledge and belief.

Rose M. Grenz
(Signature of Registrant)

Subscribed and sworn to before me this 9th day of January, 19 5

My commission expires

U. H. Lawson
(Notary Public)

(SEAL)

SEE PAGE GR-279 G FOR
CERTIFICATE OF REGISTRATION

STATE OF OREGON
County of Marion } ss.

~~This is to certify that the foregoing Registration Statement was received in the office of the State Engineer on the ... day of ... 19... and has been duly recorded in vol. of Water Right Registration Statements on page ... and the water certificate shall be completed by ... and the water actually applied to ... by ...~~

Witness my hand this ..... day of ....., 19.....

(State Engineer)

By .....
(Deputy)

GR-279 C

RECEIVED
NOV 15 1956
STATE ENGINEER
SALEM, OREGON

REGISTRATION NO. GR-299
CERTIFICATE NO. GR-279

Registration Statement

OF CLAIMANT OF RIGHT TO APPROPRIATE GROUND WATER

(Under Chapter 708, Oregon Laws 1955.)

TO THE STATE ENGINEER OF OREGON:

I, Rose M. Grenz,

of Rt. 2, Box 428A, Albany County of Linn

State of Oregon, do hereby make application for a certificate of registration as evidence of a right to appropriate ground water.

1. **Source** from which water is withdrawn is Pump Well No. 2 (Flowing well, pump well, infiltration trench, or tunnel)

2. **Location** is: ½ mile west of Jefferson, Oregon (Approximate distance and direction from nearest city or town);

and is more particularly described as follows:

(a) N. 23° E. 28 chains from the SW corner of SE¼ of S. 11, T. 10 S., R. 3 W.W.M. (Give distance and bearing to corner of section or other legal subdivision)

being within NW¼ of SE¼ (Smallest legal subdivision) of Sec. 11, Twp. 10 S (N. or S.), Rge. 3 W. (E. or W.)

or (b) within limits of recorded platted property, town or city:

in Lot ....., Block ..... of ..... (Name of plat or addition)

..... (If within city or town, give name) County of Linn

3. **Construction Work** was begun on April 12, 1953 (Date); was completed on April 14, 1953 (Date)

and the ground water claimed was first used for the purposes set out below on May 10, 1953 (Date),

since which time the water has been used continuously (Continuously or intermittently)

from May 10, 1953 (Date) to present time (Date)

4. **Quantity** of water claimed and used is 250 gallons per minute; 10 acre feet per year.

5. **Purpose or Purposes** for which water is used Irrigation

..... (Domestic, irrigation, municipal, manufacturing, industrial, etc.)

6. **Description of Well:** Depth 28 feet. Type drilled (Dug or drilled)

diameter 8 inches. Elevation of ground at well site 215 (As near as known) feet, mean sea level.

Depth to water table 10 feet.

7. **Capacity of Well:** 300 g.p.m. with 4 feet drawdown.

..... g.p.m. with ..... feet drawdown.

Date of test Not tested

If Flowing Well: Measured discharge ..... g.p.m. on ..... (Date)

Shut-in pressure at ground surface ..... lbs. per sq. in. on ..... (Date)

Water is controlled by ..... (Cap, valve, etc.)

GR-279 D

8. **Casing:** (Give diameter, commercial specifications and depth below ground surface of each casing size.)

8 inch diameter Steel casing from 0 to 28 feet

..... inch diameter ..... from ..... to ..... feet

..... inch diameter ..... from ..... to ..... feet

..... inch diameter ..... from ..... to ..... feet

Describe and show depth of shoe, plug, adapter, liner or other details: .....

9. **Perforated Casings or Screens:**

Slit perforations from 18' to 28'
(Number per foot and size of perforations, or describe screen)

..... from ..... to .....

..... from ..... to .....

..... from ..... to .....

10. **Log of Well:** (Describe each stratum or formation clearly, indicate if water bearing, and give thickness and depth as indicated.)

MATERIAL	Thickness (Feet)	Depth to Bottom (Feet)
Not available		

GR-279 E

If log of well is not available, give name and address of driller. Weymore Well Drillers & Contractors

Rt. 2, Box 317 Salem, Oregon

11. **Infiltration Trench:** Covered or open .....

Dimensions: Length ..... ft. Minimum depth ..... ft. Maximum depth ..... ft.

Bottom width ..... ft. Discharge ..... g.p.m. Date of test .....

12. **Tunnel:** Type of lining .....

Dimensions: .....
(Length, course, and cross sectional size)

Position of water bearing stratum with reference to portal of tunnel .....

Log of tunnel: (Preceding table for log of well may be used, if desired. Give footage from portal and character of materials, as pertinent.)

13. **Pumping Equipment:**

(a) Pump Berkley 2" centrifugal ..... Capacity 300 ..... g.p.m.
(Make, type and size)

(b) Motor 10 H.P. electric .....
(Type and horsepower)

14. Location of area irrigated or to be irrigated, or place of use if for purposes other than irrigation.

Township North or South	Range E. or W. of Willamette Meridian	Section	Forty-acre Tract	Number Acres To Be Irrigated	Date of Reclamation
10 S	3 W	11	NW¼ of SE¼	3.0	5/10/53
10 S	3 W	11	SW¼ of SE¼	1.0	"
				4.0	

15. If the ground water supply is supplemental to an existing water supply, identification of any application for a permit, permit, certificate or adjudicated right to appropriate water made or held by the registrant.

.....

.....

GR-279F

Township 10 Range 3 W, W.M.

North

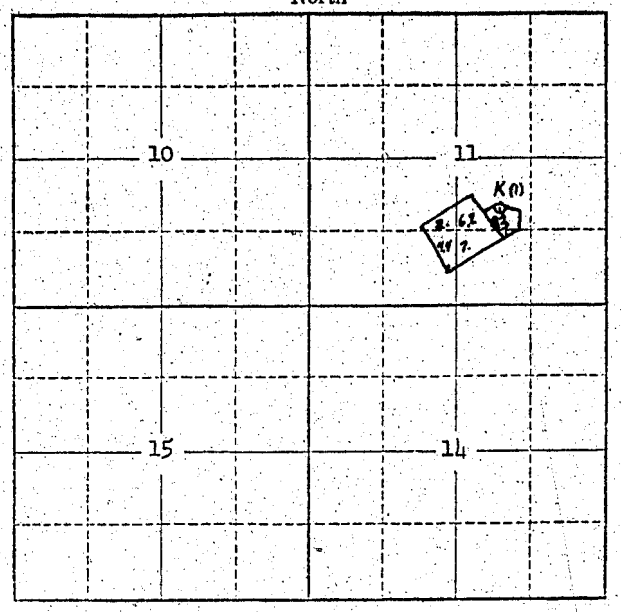

Locate well and acreage of irrigated land on plat.

Scale: 2" = 1 Mile

STATE OF OREGON
County of Linn } ss.

I, Rose M. Grenz, being first duly sworn, do hereby certify that I have read the foregoing Registration Statement and that all of the items therein contained are true to the best of my knowledge and belief.

Rose M. Grenz
(Signature of Registrant)

Subscribed and sworn to before me this 9th day of November, 1956.

My commission expires NOTARY PUBLIC FOR OREGON My Commission Expires June 15, 1957 A. K. Larson
(Notary Public)

(SEAL)

CERTIFICATE OF REGISTRATION

STATE OF OREGON
County of Marion } ss.

This is to certify that the foregoing Registration Statement was received in the office of the State Engineer on the 15th day of November, 1956, at 8 o'clock A.M. and has been duly recorded in said office in Book No. 2, of Registration Statements on page GR-279-G.

~~Construction completed by 19 and the water completely applied to beneficial use by~~

Witness my hand this 15th day of January, 1957.

Lewis A. Stanley
(State Engineer)

By
(Deputy)

GR-279 G