

# Registration Statement CERTIFICATE NO. GR-2799

## OF CLAIMANT OF RIGHT TO APPROPRIATE GROUND WATER

(Under Chapter 708, Oregon Laws 1955.)

TO THE STATE ENGINEER OF OREGON:

I, Oregon State College  
of Corvallis, Oregon County of Benton

State of Oregon, do hereby make application for a certificate of registration as evidence of a right to appropriate ground water.

1. Source from which water is withdrawn is pump well  
(Flowing well, pump well, infiltration trench, or tunnel)

2. Location is: 1E, 1/2N Corvallis, Oregon  
(Approximate distance and direction from nearest city or town)

and is more particularly described as follows:

(a) 3260' N, 150' E of N.W. Cor. Pleasant Robinette D.L.C. 71  
(Give distance and bearing to corner of section or other legal subdivision)

being within S<sup>1</sup>/<sub>4</sub> of NE<sup>1</sup>/<sub>4</sub> of Sec. 36 Twp. 11S Rge. 5W  
(Smallest legal subdivision) (N or S.) (E or W.)

or (b) within limits of recorded platted property, town or city:

in Lot \_\_\_\_\_, Block \_\_\_\_\_ of \_\_\_\_\_  
(Name of plat or addition)

County of \_\_\_\_\_  
(If within city or town, give name)

3. Construction Work was begun on \_\_\_\_\_; was completed on Apr. 27, 1947  
(Date) (Date)

and the ground water claimed was first used for the purposes set out below on \_\_\_\_\_  
(Date)

since, which time the water has been used continuously  
(Continuously or intermittently)

from 1947 to present  
(Date) (Date)

4. Quantity of water claimed and used is 165 gallons per minute; 45 acre feet per year.

5. Purpose or Purposes for which water is used irrigation for agricultural research

(Domestic, irrigation, municipal, manufacturing, industrial, etc.)

6. Description of Well: Depth 25' 5" feet. Type drilled  
(Dug or drilled)

diameter 18 inches. Elevation of ground at well site 220 feet, mean sea level.  
(As near as known)

Depth to water table 16.5' feet.

7. Capacity of Well: 165 g.p.m. with 1.5 feet drawdown.

\_\_\_\_\_ g.p.m. with \_\_\_\_\_ feet drawdown.

Date of test July 17, 1947

If Flowing Well: Measured discharge \_\_\_\_\_ g.p.m. on \_\_\_\_\_  
(Date)

Shut-in pressure at ground surface \_\_\_\_\_ lbs. per sq. in. on \_\_\_\_\_  
(Date)

Water is controlled by \_\_\_\_\_  
(Cap, valve, etc.)

8. **Casing:** (Give diameter, commercial specifications and depth below ground surface of each casing size.)

- - inch diameter pit from 0 to 6.5 feet  
18" inch diameter concrete pipe from 6.5 to 24.5 feet  
inch diameter from to feet  
inch diameter from to feet

Describe and show depth of shoe, plug, adapter, liner or other details:  
perforations -- Holes in bottom section of pipe plus open end

9. **Perforated Casings or Screens:**

..... from ..... to .....  
(Number per foot and size of perforations, or describe screen)  
..... from ..... to .....  
..... from ..... to .....  
..... from ..... to .....

10. **Log of Well:** (Describe each stratum or formation clearly, indicate if water bearing, and give thickness and depth as indicated.) Unknown

MATERIAL	Thickness (Feet)	Depth to Bottom (Feet)

If log of well is not available, give name and address of driller. Unknown

11. Infiltration Trench: Covered or open .....

Dimensions: Length ..... ft. Minimum depth ..... ft. Maximum depth ..... ft.

Bottom width ..... ft. Discharge ..... g.p.m. Date of test .....

12. Tunnel: Type of lining .....

Dimensions: .....  
(Length, course, and cross sectional size)

Position of water bearing stratum with reference to portal of tunnel .....

Log of tunnel: (Preceding table for log of well may be used, if desired. Give footage from portal and character of materials, as pertinent.)

13. Pumping Equipment:

(a) Pump Fairbanks-Morse 3 1/2 x 2 1/2 x 7 1/2 Capacity 165 g.p.m.  
(Make, type and size)


(b) Motor Fairbanks-Morse 10 HP - 3 phase  
(Type and horsepower)

14. Location of area irrigated or to be irrigated, or place of use if for purposes other than irrigation.

Township North or South	Range E. or W. of Willamette Meridian	Section	Forty-acre Tract	Number Acres To Be Irrigated	Date of Reclamation
11S	5W	36	SW 1/4 of NE 1/4	11.3	April 27, 1947
"	"	"	SE 1/4 of NE 1/4	6.0	"
"	"	"	NW 1/4 of NE 1/4	.7	"
"	"	"	NE 1/4 of NE 1/4	.4	"
				18.4	

15. If the ground water supply is supplemental to an existing water supply, identification of any application for a permit, permit, certificate or adjudicated right to appropriate water made or held by the registrant.

Township 11 S Range 5 W, W.M.  
North

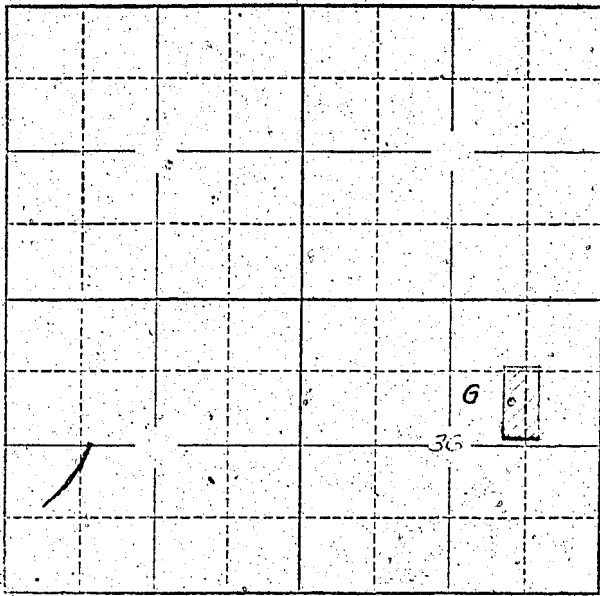

Locate well and acreage of irrigated land on plat.  
Scale: 2" = 1 Mile

STATE OF OREGON }  
County of Benton } ss.

I, G. Morris Robertson, being first duly sworn, do hereby certify that I have read the foregoing Registration Statement and that all of the items therein contained are true to the best of my knowledge and belief.

G. Morris Robertson  
Business Manager, Oregon State College

Subscribed and sworn to before me this 18 day of July, 1958

My commission expires 4 Nov 1960 W T Linn  
(Notary Public)

(SEAL)

**CERTIFICATE OF REGISTRATION**

STATE OF OREGON }  
County of Marion } ss.

This is to certify that the foregoing Registration Statement was received in the office of the State Engineer on the 29th day of July, 1958, at 8:00 o'clock A.M. and has been duly recorded in said office in Book No. 12 of Registration Statements on page GR-2799

~~Construction of the canal is completed by the date of this certificate and the water completely applied for beneficial use by the date of this certificate.~~

Witness my hand this 25th day of May, 1959

Levia A. Stanley  
(State Engineer)

By \_\_\_\_\_  
(Deputy)

\$15.00

GR-2799