

OF CLAIMANT OF RIGHT TO APPROPRIATE GROUND WATER

(Under Chapter 708, Oregon Laws 1955.)

TO THE STATE ENGINEER OF OREGON:

I, Oregon State College
of Corvallis County of Benton

State of Oregon, do hereby make application for a certificate of registration as evidence of a right to appropriate ground water.

1. Source from which water is withdrawn is pump well #2
(Flowing well, pump well, infiltration trench, or tunnel)

2. Location is: 3/4 miles S. E. of Corvallis
(Approximate distance and direction from nearest city or town)

and is more particularly described as follows:

(a) 1537' W, 1815' S of James Robinette D.L.C. 52
(Give distance and bearing to corner of section or other legal subdivision)

being within NW 1/4 of Spt of Sec. 6, Twp. 12S, Rge. 4W
(Smallest legal subdivision) (N. or S.) (E. or W.)

or (b) within limits of recorded platted property, town or city:

in Lot 23, Block of
(Name of plat or addition)

(If within city or town, give name) County of

3. Construction Work was begun on (Date); was completed on prior to 1939 (Date)

and the ground water claimed was first used for the purposes set out below on approx. 1939 (Date)

since which time the water has been used continuously
(Continuously or intermittently)

from 1939 (Date) to present (Date)

4. Quantity of water claimed and used is 180 gallons per minute; 62 acre feet per year.

5. Purpose or Purposes for which water is used

irrigation

(Domestic, irrigation, municipal, manufacturing, industrial, etc.)

6. Description of Well: Depth 31 feet. Type drilled
(Dug or drilled)

diameter 10 inches. Elevation of ground at well site 222 feet, mean sea level.
(As near as known)

Depth to water table 17 feet.

7. Capacity of Well: g.p.m. with Unknown feet drawdown.

 g.p.m. with feet drawdown.

Date of test

If Flowing Well: Measured discharge g.p.m. on (Date)

Shut-in pressure at ground surface lbs. per sq. in. on (Date)

Water is controlled by
(Cap, valve, etc.)

8. **Casing:** (Give diameter, commercial specifications and depth below ground surface of each casing size.)

.....	inch diameter		pit		from	0	to	5	feet
10	inch diameter		steel casing		from	5	to	31+	feet
.....	inch diameter				from		to		feet
.....	inch diameter				from		to		feet

Describe and show depth of shoe, plug, adapter, liner or other details: _____

9. Perforated Casings or Screens: Unknown

(Number per foot and size of perforations, or describe screen)	from	to
	from	to
	from	to
	from	to
	from	to

10. **Log of Well:** (Describe each stratum or formation clearly, indicate if water bearing, and give thickness and depth as indicated.)

[illegible]

GR- 2802

If log of well is not available, give name and address of driller. Unknown

Unknown

11. Infiltration Trench: Covered or open

Dimensions: Length ft. Minimum depth ft. Maximum depth ft.

Bottom width ft. Discharge g.p.m. Date of test

12. Tunnel: Type of lining

Dimensions: _____
(Length, course, and cross sectional size)

Position of water bearing stratum with reference to portal of tunnel

Log of tunnel: (Preceding table for log of well may be used, if desired. Give footage from portal and character of materials, as pertinent.)

13. Pumping Equipment:

(a) Pump: Pacific 2L Capacity 180 g.p.m.
(Make, type and size)


(b) Motor G. E., 7.5 hp, 220/440, 3400 rpm
(Type and horsepower)

14. Location of area irrigated or to be irrigated, or place of use if for purposes other than irrigation.

[illegible]

15. If the ground water supply is supplemental to an existing water supply, identification of any application for a permit, permit, certificate or adjudicated right to appropriate water made or held by the registrant.

Township 12S Range 1W W.M.
North

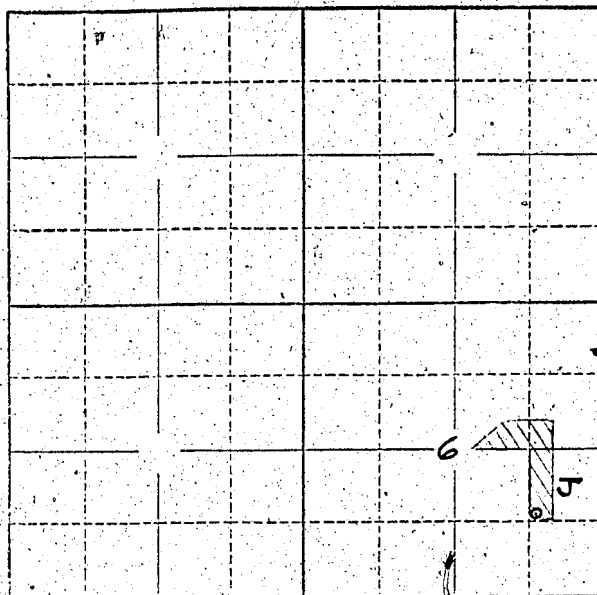

Locate well and acreage of irrigated land on plat.
Scale: 2" = 1 Mile

STATE OF OREGON

County of Benton

ss.

I, G. Morris Robertson, being first duly sworn, do hereby certify that I have read the foregoing Registration Statement and that all of the items therein contained are true to the best of my knowledge and belief.

G. Morris Robertson
Business Manager, Oregon State College

Subscribed and sworn to before me this 18 day of July, 1958

My commission expires 4 Nov 1960

W T Linn
(Notary Public)

(SEAL)

CERTIFICATE OF REGISTRATION

STATE OF OREGON

County of Marion

ss.

This is to certify that the foregoing Registration Statement was received in the office of the State Engineer on the 29th day of July, 1958, at 8:00 o'clock A. M. and has been duly recorded in said office in Book No. 12 of Registration Statements on page GR 2802

~~Construction shall be completed by 1959 and the water completely supplied by 1960~~
~~and shall be used by 1959~~ XX

Witness my hand this 25th day of May

1959

Lewis A. Stanley
(State Engineer)

By

(Deputy)

GR 2802

\$15.00