

# Registration Statement

## OF CLAIMANT OF RIGHT TO APPROPRIATE GROUND WATER

(Under Chapter 708, Oregon Laws 1955.)

TO THE STATE ENGINEER OF OREGON:

I, Oregon State College

of Corvallis County of Benton

State of Oregon, do hereby make application for a certificate of registration as evidence of a right to appropriate ground water.

1. Source from which water is withdrawn is pump well #3  
(Flowing well, pump well, infiltration trench, or tunnel)

2. Location is: 3 miles S.E. of Corvallis  
(Approximate distance and direction from nearest city or town)

and is more particularly described as follows:

(a) 2960' West, 1638' South of N.E. Corner James Robinette D.L.C. 52  
(Give distance and bearing to corner of section or other legal subdivision)

being within NW 1/4 of SE 1/4 of Sec. 6, Twp. 12S Rge. 4W W.M.  
(Smallest legal subdivision) (N. or S.) (E. or W.)

or (b) within limits of recorded platted property, town or city:

in Lot \_\_\_\_\_, Block \_\_\_\_\_ of \_\_\_\_\_  
(Name of plat or addition)

County of \_\_\_\_\_  
(If within city or town, give name)

3. Construction Work was begun on \_\_\_\_\_; was completed on April 1951  
(Date) (Date)

and the ground water claimed was first used for the purposes set out below on 1951  
(Date)

since which time the water has been used continuously  
(Continuously or intermittently)

from 1951 to present  
(Date) (Date)

4. Quantity of water claimed and used is 180 gallons per minute; 62 acre feet per year.

5. Purpose or Purposes for which water is used \_\_\_\_\_

irrigation  
(Domestic, irrigation, municipal, manufacturing, industrial, etc.)

6. Description of Well: Depth 35 feet. Type drilled  
(Dug or drilled)

diameter 10 inches. Elevation of ground at well site 222 feet, mean sea level.  
(As near as known)

Depth to water table 8 (Jan '58); 17 (July '58) feet.

7. Capacity of Well: 175 g.p.m. with 17 feet drawdown.

135 g.p.m. with 9 feet drawdown.  
67 3.5

Date of test April 1951

If Flowing Well: Measured discharge \_\_\_\_\_ g.p.m. on \_\_\_\_\_  
(Date)


Shut-in pressure at ground surface \_\_\_\_\_ lbs. per sq. in. on \_\_\_\_\_  
(Date)

Water is controlled by \_\_\_\_\_  
(Cap, valve, etc.)





Township 125 Range 11, W.M.  
North

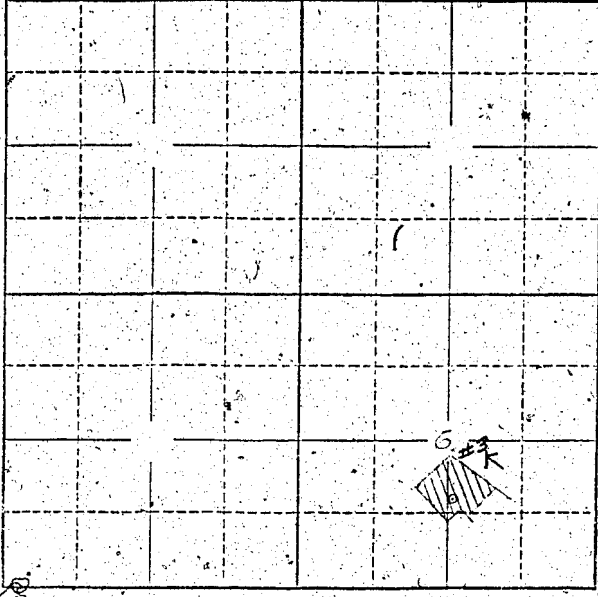

Locate well and acreage of irrigated land on plat.  
Scale: 2" = 1 Mile

STATE OF OREGON }  
County of Benton } ss.

I, G. Morris Robertson, being first duly sworn, do hereby certify that I have read the foregoing Registration Statement and that all of the items therein contained are true to the best of my knowledge and belief.

G. Morris Robertson  
Business Manager, Oregon State College

Subscribed and sworn to before me this 18 day of July, 19 58

My commission expires 4 Nov 1960

W T Linn  
(Notary Public)

(SEAL)

**CERTIFICATE OF REGISTRATION**

STATE OF OREGON }  
County of Marion } ss.

This is to certify that the foregoing Registration Statement was received in the office of the State Engineer on the 29th day of July, 1958, at 8:00 o'clock A. M. and has been duly recorded in said office in Book No. 12 of Registration Statements on page GR- 2803

~~Construction shall be completed by 19 and the order completely applied to 19 by 19~~

Witness my hand this 25th day of May, 19 59

Louis A. Stanley  
(State Engineer)

By \_\_\_\_\_  
(Deputy)

\$15.00

GR- 2803