

Registration Statement

REGISTRATION NO. GR-2995
 CERTIFICATE NO. GR-2804

OF CLAIMANT OF RIGHT TO APPROPRIATE GROUND WATER

(Under Chapter 708, Oregon Laws 1955.)

TO THE STATE ENGINEER OF OREGON:

I, Oregon State College

of Corvallis County of Benton

State of Oregon, do hereby make application for a certificate of registration as evidence of a right to appropriate ground water.

1. Source from which water is withdrawn is pump well
(Flowing well, pump well, infiltration trench, or tunnel)

2. Location is: 4 miles S. E. of Corvallis
(Approximate distance and direction from nearest city or town)

and is more particularly described as follows:

(a) 1254' W, 2260' S of James Robinette D.L.C. 52
(Give distance and bearing to corner of section or other legal subdivision)

being within NW 1/4 of SE 1/4 of Sec. 6, Twp. 12S, Rge. 4W
(Smallest legal subdivision) (N. or S.) (E. or W.)

or (b) within limits of recorded platted property, town or city:

in Lot _____, Block _____ of _____
(Name of plat or addition)

(If within city or town, give name)

County of _____

3. Construction Work was begun on _____; was completed on Dec. 8, 1952
(Date) (Date)

and the ground water claimed was first used for the purposes set out below on 1953
(Date)

since which time the water has been used continuously
(Continuously or Intermittently)

from 1953 to present
(Date) (Date)

4. Quantity of water claimed and used is 360 gallons per minute; _____ acre feet per year.

5. Purpose or Purposes for which water is used _____

irrigation

(Domestic, irrigation, municipal, manufacturing, industrial, etc.)

6. Description of Well: Depth 35 feet. Type drilled
(Dug or drilled)

diameter 8 inches. Elevation of ground at well site 222 feet, mean sea level.
(As near as known)

Depth to water table 18.7 feet.

7. Capacity of Well: 350 g.p.m. with 5 feet drawdown.

210 g.p.m. with 2.5 feet drawdown.

Date of test 12/8/52

If Flowing Well: Measured discharge _____ g.p.m. on _____
(Date)

Shut-in pressure at ground surface _____ lbs. per sq. in. on _____
(Date)

Water is controlled by _____
(Cap, valve, etc.)

size.)

8

Describe and show depth of shoe, plug, adapter, liner or other details: _____

9. Perforated Casings or Screens:

(Number per foot and size of perforations, or describe screen)

ness and depth as indicated.)

MATERIAL

Thickness
(Feet)

Depth to Bottom
(Feet)

Soil

2

2

Sand and gravel with a little clay

13

15

Sand and gravel with considerable clay

2

17


Coarse gravel with some sand

18

35

GR- 2804

Township 12S Range 4W, W.M.
North

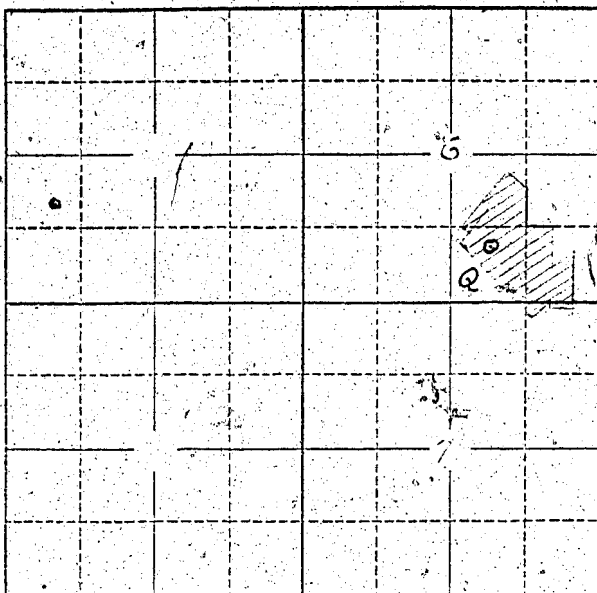

Locate well and acreage of irrigated land on plat.

Scale: 2" = 1 Mile

STATE OF OREGON

County of Benton

ss.

I, G. Morris Robertson, being first duly sworn, do hereby certify that I have read the foregoing Registration Statement and that all of the items therein contained are true to the best of my knowledge and belief.

G. Morris Robertson
Business Manager, Oregon State College

Subscribed and sworn to before me this 18 day of July, 19 58

My commission expires 4 Nov 1960

W T Lemmon
(Notary Public)

(SEAL)

CERTIFICATE OF REGISTRATION

STATE OF OREGON

County of Marion

ss.

This is to certify that the foregoing Registration Statement was received in the office of the State Engineer on the 29th day of July, 19 58, at 8:00 o'clock A.M. and has been duly recorded in said office in Book No. 12 of Registration Statements on page GR-2804

~~XX Construction of the dam completed by 1959 and the water completely applied to beneficial uses by 1960 XX~~

Witness my hand this 25th day of May, 19 59

Lewis A. Stanley
(State Engineer)

By

(Deputy)

GR-2804

\$19.50