

Registration Statement

OF CLAIMANT OF RIGHT TO APPROPRIATE GROUND WATER

TO THE STATE ENGINEER OF OREGON:

I, Oregon State College

of Corvallis (Mailing address) County of Benton

State of Oregon do hereby make application for a certificate of registration as evidence of a right to appropriate ground water.

1. Source from which water is withdrawn is pump well #1
(Flowing well, pump well, infiltration trench, or tunnel)

2. Location is: 1 mile East of Corvallis
(Approximate distance and direction from nearest city or town)

and is more particularly described as follows:

(a) 2100' W, 1440' N of N.W. Cor. Pleasant Robinette D.L.C.
(Give distance and bearing to corner of section or other legal subdivision)

being within NW 1/4 of SW 1/4 of Sec. 36, Twp. 11S, Rge. 5W
(Smallest legal subdivision) (N. or S.) (E. or W.)

or (b) within limits of recorded platted property, town or city:

in Lot _____, Block _____ of _____
(Name of plat or addition)

County of _____
(If within city or town, give name)

3. Construction Work was begun on _____; was completed on April 1951
(Date) (Date)

and the ground water claimed was first used for the purposes set out below on 1951
(Date)

since which time the water has been used continuously
(Continuously or intermittently)

from 1951 to present
(Date) (Date)

4. Quantity of water claimed and used is 150 gallons per minute; 57 acre feet per year.

5. Purpose or Purposes for which water is used irrigation for agricultural research

(Domestic, irrigation, municipal, manufacturing, industrial, etc.)

6. Description of Well: Depth 41 feet. Type drilled
(Dug or drilled)

diameter 10 inches. Elevation of ground at well site 220 feet, mean sea level.
(As near as known)

Depth to water table 15 feet.

7. Capacity of Well: 400 g.p.m. with 8 feet drawdown.
345 g.p.m. with 6.5 feet drawdown.
160 g.p.m. with 3.5 feet drawdown.


Date of test April 2, 1951

If Flowing Well: Measured discharge _____ g.p.m. on _____
(Date)

Shut-in pressure at ground surface _____ lbs. per sq. in. on _____
(Date)

Water is controlled by _____
(Cap, valve, etc.)

Township 115 Range 5 W, W.M.
North

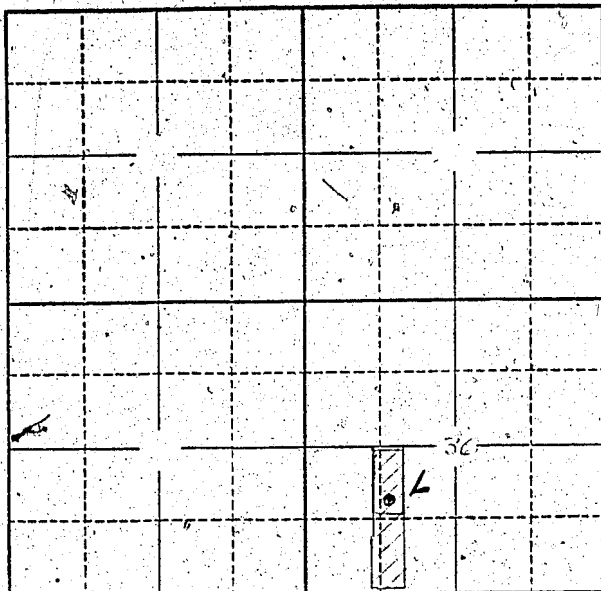

Locate well and acreage of irrigated land on plat.
Scale: 2" = 1 Mile

STATE OF OREGON

County of Benton } ss.

I, G. Morris Robertson, being first duly sworn, do hereby certify that I have read the foregoing Registration Statement and that all of the items therein contained are true to the best of my knowledge and belief.

G. Morris Robertson

Subscribed and sworn to before me this 18 day of July, 1958

My commission expires 4 Nov 1960 WT Stanley
(Notary Public)

(SEAL)

CERTIFICATE OF REGISTRATION

STATE OF OREGON

County of Marion } ss.

This is to certify that the foregoing Registration Statement was received in the office of the State Engineer on the 29th day of July, 1958, at 8:00 o'clock A. M. and has been duly recorded in said office in Book No. 12 of Registration Statements on page GR-2805

Witness my hand this 25th day of May, 1959

Lewis A. Stanley
(State Engineer)

By _____ (Deputy)

\$15.00

GR - 2805