

Registration Statement

OF CLAIMANT OF RIGHT TO APPROPRIATE GROUND WATER

TO THE STATE ENGINEER OF OREGON:

I, P. H. TURMIDGE

of PT 2, Box 310 ALBANY County of Linn

State of OREGON, do hereby make application for a certificate of registration as evidence of a right to appropriate ground water.

1. Source from which water is withdrawn is PUMP WELL NO. 1
(Flowing well, pump well, infiltration trench, or tunnel)

2. Location is: 5 M. NORTH OF ALBANY, ORE.
(Approximate distance and direction from nearest city or town)

and is more particularly described as follows:

(a) N. 71° 30' W. 24 CHAINS FROM SE CORNER OF NW 1/4 S. 13 T. 25 S. R. 4 W.
(Give distance and bearing to corner of section or other legal subdivision)

being within SW 1/4 OF NW 1/4 of Sec. 13, Twp. 10 S, Rge. 4 W
(Smallest legal subdivision) (N. or S.) (E. or W.)

or (b) within limits of recorded platted property, town or city: _____

in Lot _____, Block _____ of _____
(Name of plat or addition)

County of Linn
(If within city or town, give name)

3. Construction Work was begun on MAY 1, 1951; was completed on MAY 1, 1951
(Date) (Date)

and the ground water claimed was first used for the purposes set out below on MAY 15, 1951
(Date)

since which time the water has been used CONTINUOUSLY
(Continuously or intermittently)

from MAY 15, 1951 to PRESENT TIME
(Date) (Date)

4. Quantity of water claimed and used is 450 gallons per minute; 10.71 acre feet per year.

5. Purpose or Purposes for which water is used IRRIGATION

(Domestic, irrigation, municipal, manufacturing, industrial, etc.)

6. Description of Well: Depth 32 feet. Type DRILLED
(Dug or drilled)

diameter 7.0 inches. Elevation of ground at well site 170 feet, mean sea level.
(As near as known)

Depth to water table 12 feet.

7. Capacity of Well: 500 g.p.m. with 1 feet drawdown.

_____ g.p.m. with _____ feet drawdown.

Date of test MAY 1, 1951

If Flowing Well: Measured discharge _____ g.p.m. on _____
(Date)

Shut-in pressure at ground surface _____ lbs. per sq. in. on _____
(Date)

Water is controlled by _____
(Cap, valve, etc.)

If log of well is not available, give name and address of driller. BILL HAMMERS DRILLING

Co., ALBANY, ORE.

11. Infiltration Trench: Covered or open
 Dimensions: Length ft. Minimum depth ft. Maximum depth ft.
 Bottom width ft. Discharge g.p.m. Date of test

12. Tunnel: Type of lining
 Dimensions:
 (Length, course, and cross sectional size)
 Position of water bearing stratum with reference to portal of tunnel

Log of tunnel: (Preceding table for log of well may be used, if desired. Give footage from portal and character of materials, as pertinent.)

13. Pumping Equipment:
 (a) Pump PACIFIC CENTRIFUGAL Capacity 450 g.p.m.
 (Make, type and size)
 (b) Motor 15 H.P. ELECTRIC
 (Type and horsepower)

14. Location of area irrigated or to be irrigated, or place of use if for purposes other than irrigation.

| Township North or South | Range E. or W. of Willamette Meridian | Section | Forty-acre Tract | Number Acres To Be Irrigated | Date of Reclamation |
|-------------------------|---------------------------------------|---------|------------------|------------------------------|---------------------|
| 10S | 4W | 12 | SE 1/4 OF NW 1/4 | 27.0 | MAY 15, 1951 |
| 10S | 4W | 13 | NW 1/4 OF SW 1/4 | 5.6 | " " " |
| 10S | 4W | 14 | SE 1/4 OF NE 1/4 | 3.1 | " " " |
| | | | | 35.7 | |

... have bargained, sold and quitclaimed and by ...
 sell and quitclaim unto PERCY L. TURNIDGE and CORDELIA TURNIDGE, husband and wife


the following described premises, to-wit:

Beginning at the northwest corner of Claim 72, Township 10 South, Range 4 West of the Willamette Meridian; thence east 32 chains to angle corner of said Claim; thence south 5.75 chains to interior corner of said claim; thence east 50 chains to the southeast corner of Claim 74 in said township and Range; thence north 5.94 chains; thence east 16 chains; thence south 8 chains; thence west 10 chains; thence south 6.98 chains to a point 9.04 chains south and 5.90 chains east of the said southeast corner of said claim 74; thence west parallel with north boundary of said claim 72; 41.23 chains more or less, to the center line of the county road, being the northeast corner of the tract of land conveyed by Alfred C. Schultz and wife to Mary L. Mulligan, by Deed Record 142 Page 335; thence southeasterly along the center line of said county road 13.88 chains more or less, to the southeast corner of said tract conveyed to Mary L. Mulligan; thence west parallel to the north line of claim 72, 19.15 chains to the west line of said claim being the southwest corner of said tract conveyed to Mary L. Mulligan; thence North 31 1/2° west 7.74 chains along said west claim line; thence North 49° west 33.50 chains along said claim line to the place of beginning.

15. If the ground water supply is supplemental to an existing water supply, identification of any application for a permit, permit, certificate or adjudicated right to appropriate water made or held by the registrant.

Township 125 Range 40, W.M.

North

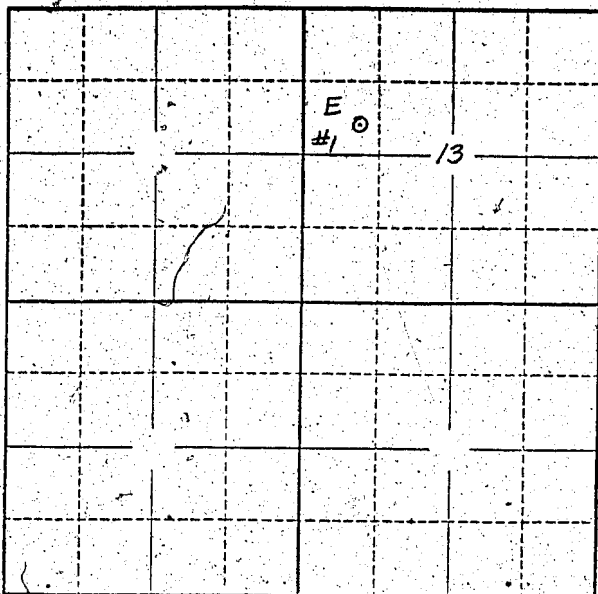

Locate well and acreage of irrigated land on plat.

Scale: 2" = 1 Mile

STATE OF OREGON

County of Linn } ss.

I, P. L. TURNIDGE, being first duly sworn, do hereby certify that I have read the foregoing Registration Statement and that all of the items therein contained are true to the best of my knowledge and belief.

P. L. Turnidge
(Signature of Registrant)

Subscribed and sworn to before me this 26th day of July, 1958

My commission expires _____
(Notary Public)

(SEAL)

CERTIFICATE OF REGISTRATION

STATE OF OREGON

County of Marion } ss.

This is to certify that the foregoing Registration Statement was received in the office of the State Engineer on the 29 day of July, 1958, at 8:00 o'clock A. M. and has been duly recorded in said office in Book No. 12 of Registration Statements on page GR-2806

Witness my hand this 25th day of May, 1959

W. A. Stanley
(State Engineer)

By _____
(Deputy)

GR - 2806

\$15.00