

# Registration Statement

## OF CLAIMANT OF RIGHT TO APPROPRIATE GROUND WATER

TO THE STATE ENGINEER OF OREGON:

I, P. L. TURMIDGE

of Rt. 2, Box 310, Albany

(Mailing address)

County of Linn

State of OREGON, do hereby make application for a certificate of registration as evidence of a right to appropriate ground water.

1. Source from which water is withdrawn is PUMP WELL  
(Flowing well, pump well, infiltration trench, or tunnel)

2. Location is: 5 M. N. W. ALBANY, ORE.  
(Approximate distance and direction from nearest city or town)

and is more particularly described as follows:

(a) S. 15° 30' W. 70 CHAINS FROM NE CORNER OF SEC. 25 S. 13 T. 10 S. R. 4 W.  
(Give distance and bearing to corner of section or other legal subdivision)

being within NE 1/4 S. 26 of Sec. 13, Twp. 10 S., Rge. 7 W.  
(Smallest legal subdivision) (N. or S.) (E. or W.)

or (b) within limits of recorded platted property, town or city:

in Lot \_\_\_\_\_, Block \_\_\_\_\_ of \_\_\_\_\_  
(Name of plat or addition)

(If within city or town, give name)

County of Linn

3. Construction Work was begun on APRIL 10, 1952; was completed on APRIL 21, 1950  
(Date) (Date)

and the ground water claimed was first used for the purposes set out below on MAY 15, 1950  
(Date)

since which time the water has been used CONTINUOUSLY  
(Continuously or intermittently)

from MAY 15, 1950 to PRESENT TIME  
(Date) (Date)

4. Quantity of water claimed and used is 450 gallons per minute; 131.4 acre feet per year.

5. Purpose or Purposes for which water is used IRRIGATION

(Domestic, irrigation, municipal, manufacturing, industrial, etc.)

6. Description of Well: Depth 38 feet. Type DRILED  
(Dug or drilled)

diameter 10 inches. Elevation of ground at well site 170 feet, mean sea level.  
(As near as known)

Depth to water table 14 feet.

7. Capacity of Well: 500 g.p.m. with 5 feet drawdown.

6 g.p.m. with 5 feet drawdown.

Date of test MAY 15, 1950

If Flowing Well: Measured discharge \_\_\_\_\_ g.p.m. on \_\_\_\_\_  
(Date)


Shut-in pressure at ground surface \_\_\_\_\_ lbs. per sq. in. on \_\_\_\_\_  
(Date)

Water is controlled by \_\_\_\_\_  
(Cap, valve, etc.)





Township 10S Range 4E, W.M.  
North

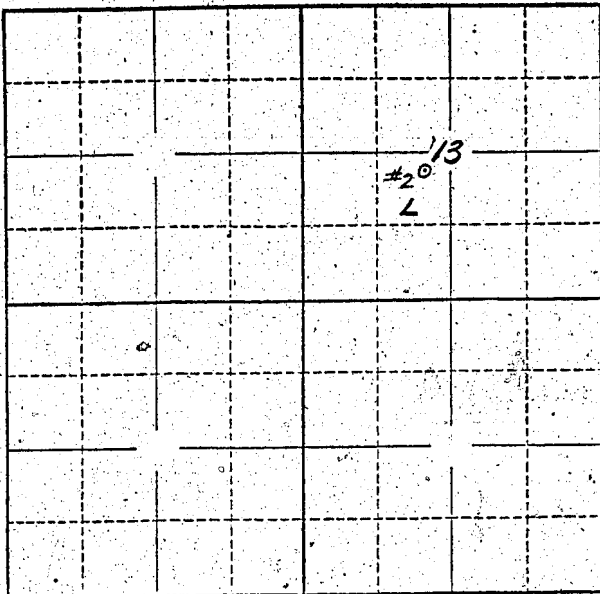

Locate well and acreage of irrigated land on plat.  
Scale: 2" = 1 Mile

STATE OF OREGON

County of LINCOLN } ss.

I, P. L. TURNIDGE, being first duly sworn, do hereby certify that I have read the foregoing Registration Statement and that all of the items therein contained are true to the best of my knowledge and belief.

P. L. Turnidge  
(Signature of Registrant)

Subscribed and sworn to before me this 26<sup>th</sup> day of July, 1958

My commission expires \_\_\_\_\_

Harold H. McKee  
(Notary Public)

(SEAL)

**CERTIFICATE OF REGISTRATION**

STATE OF OREGON

County of Marion } ss.

This is to certify that the foregoing Registration Statement was received in the office of the State Engineer on the 29 day of July, 1958, at 8:20 o'clock A. M. and has been duly recorded in said office in Book No. 12 of Registration Statements on page GR-2807

Witness my hand this 25<sup>th</sup> day of May, 1959

Lawrence A. Stanley  
(State Engineer)

By \_\_\_\_\_ (Deputy)

\$17.10

GR-2807