

RECEIVED  
OCT 11 1955

# Registration Statement

## OF CLAIMANT OF RIGHT TO APPROPRIATE GROUND WATER

(Under Chapter 708, Oregon Laws 1955.)

TO THE STATE ENGINEER OF OREGON:

Edward A. Hari  
Route 3-Box 103  
Suverton, Oregon

I, \_\_\_\_\_

of \_\_\_\_\_ County of \_\_\_\_\_

State of \_\_\_\_\_ do hereby make application for a certificate of registration as evidence of a right to appropriate ground water.

1. Source from which water is withdrawn is Pump Well  
(Flowing well, pump well, infiltration trench, or tunnel)

2. Location is: 4 miles southeast of Suverton  
(Approximate distance and direction from nearest city or town)

and is more particularly described as follows:

(a) Southwest corner of S.M. 151944-0-04 by mountain and Suverton 2002  
(Give distance and bearing to corner of section or other legal subdivision) 400 ft. west from SE corner of  
being within S.E. 1/4 of S. 1/4 of Sec. 8 of Sec. 8, Twp. 7 S, Rge. 1 W  
(Smallest legal subdivision) (N. or S.) (E. or W.)

or (b) within limits of recorded platted property, town or city: \_\_\_\_\_

in Lot \_\_\_\_\_, Block \_\_\_\_\_ of \_\_\_\_\_

(Name of plat or addition)

\_\_\_\_\_ County of \_\_\_\_\_

(If within city or town, give name)

3. Construction Work was begun on April 1, 1953; was completed on Feb. 1, 1954  
(Date) (Date)

and the ground water claimed was first used for the purposes set out below on June 1, 1954  
(Date)

since which time the water has been used continuously during growing season  
(Continuously or intermittently)

from June 1, 1954 to June 1, 1955  
(Date) (Date)

4. Quantity of water claimed and used is 72 gallons per minute; \_\_\_\_\_ acre feet per year.

5. Purpose or Purposes for which water is used Irrigation

(Domestic, irrigation, municipal, manufacturing, industrial, etc.)

6. Description of Well: Depth 30.9 feet. Type 2  
(Dug or drilled)

diameter 10 to 8 inches. Elevation of ground at well site \_\_\_\_\_ feet, mean sea level.  
(As near as known)

Depth to water table 15 feet.

7. Capacity of Well: 72 g.p.m. with 16.8 feet drawdown.

\_\_\_\_\_ g.p.m. with \_\_\_\_\_ feet drawdown.

Date of test Jan 7, 1954

If Flowing Well: Measured discharge \_\_\_\_\_ g.p.m. on \_\_\_\_\_  
(Date)

Shut-in pressure at ground surface \_\_\_\_\_ lbs. per sq. in. on \_\_\_\_\_  
(Date)

Water is controlled by \_\_\_\_\_

(Cap, valve, etc.)






Beginning at the Southwest corner of the Donation Land Claim of Joseph W. Blackerby and Cassandra Blackerby his wife in Twp 7, Range 1, W.M., and running thence North 93 rods, thence East 42.42 Rods, thence South 9 rods, thence West 16 feet.

Township 7 Range 1, W.M.

North

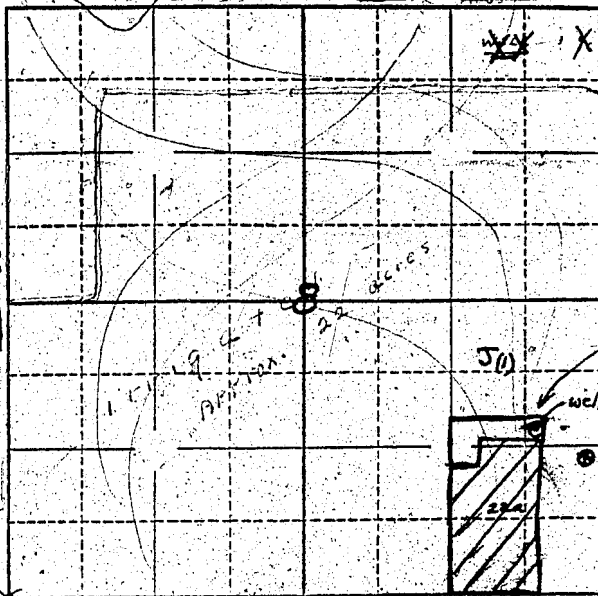

See Attached Sheets

Locate well and acreage of irrigated land on plat.

Scale 1" = 1 Mile  
4" = 1 Mile

STATE OF OREGON

County of Marion } ss.

I, Edward J. Lewis, being first duly sworn, do hereby certify that I have read the foregoing Registration Statement and that all of the items therein contained are true to the best of my knowledge and belief.

Edward J. Lewis  
(Signature of Registrant)

Subscribed and sworn to before me this 5th day of January, 1956

My commission expires 12-26-58 / Francis Nelson Russell  
(Notary Public)

(SEAL)

**CERTIFICATE OF REGISTRATION**

STATE OF OREGON

County of Marion } ss.

This is to certify that the foregoing Registration Statement was received in the office of the State Engineer on the 31st day of October, 1955, at 8:00 o'clock A. M. and has been duly recorded in said office in Book No. 1 of Registration Statements on page 26

Construction shall be completed by 18 1956, and the water completely applied to beneficial use by 19 1956

Witness my hand this 24th day of February, 1956

Lewis A. Stanley  
(State Engineer)

By \_\_\_\_\_  
(Deputy)