

Registration Statement

OF CLAIMANT OF RIGHT TO APPROPRIATE GROUND WATER

TO THE STATE ENGINEER OF OREGON:

I, P. L. TURNER

of RT 2, Box 310, Albany County of Linn

(Mailing address)

County of Linn

State of OREGON, do hereby make application for a certificate of registration as evidence of a right to appropriate ground water.

1. Source from which water is withdrawn is PUMP WELL No. 4
(Flowing well, pump well, infiltration trench, or tunnel)

2. Location is: 5 MILES N. OF ALBANY, ORE.
(Approximate distance and direction from nearest city or town)

and is more particularly described as follows:

(a) N 77° E 41 CHAINS FROM SW CORNER CORNER OF S 13, T 10 S, R 4 W
(Give distance and bearing to corner of section or other legal subdivision)

being within SW 1/4 OF NW 1/4 of Sec. 18, Twp. 10 S, Rge. 3 W
(Smallest legal subdivision) (N. or S.) (E. or W.)

or (b) within limits of recorded platted property, town or city:

in Lot _____, Block _____ of _____
(Name of plat or addition)

County of Linn
(If within city or town, give name)

3. Construction Work was begun on SEPT. 25, 1951; was completed on SEPT. 25, 1951
(Date) (Date)

and the ground water claimed was first used for the purposes set out below on MAY 12, 1952
(Date)

since which time the water has been used CONTINUOUSLY
(Continuously or Intermittently)

from MAY 12, 1952 to PRESENT TIME
(Date) (Date)

4. Quantity of water claimed and used is 500 gallons per minute; 144 acre feet per year.

5. Purpose or Purposes for which water is used IRRIGATION

(Domestic, irrigation, municipal, manufacturing, industrial, etc.)

6. Description of Well: Depth 30 feet. Type DRILED
(Dug or drilled)

diameter 10 inches. Elevation of ground at well site 170 feet, mean sea level.
(As near as known)

Depth to water table 10 feet.

7. Capacity of Well: 600 g.p.m. with 1 feet drawdown.

_____ g.p.m. with _____ feet drawdown.


Date of test SEPT. 25, 1951

If Flowing Well: Measured discharge _____ g.p.m. on _____
(Date)

Shut-in pressure at ground surface _____ lbs. per sq. in. on _____
(Date)

Water is controlled by _____
(Cap, valve, etc.)

Township 10 S Range 7 W W.M.
North

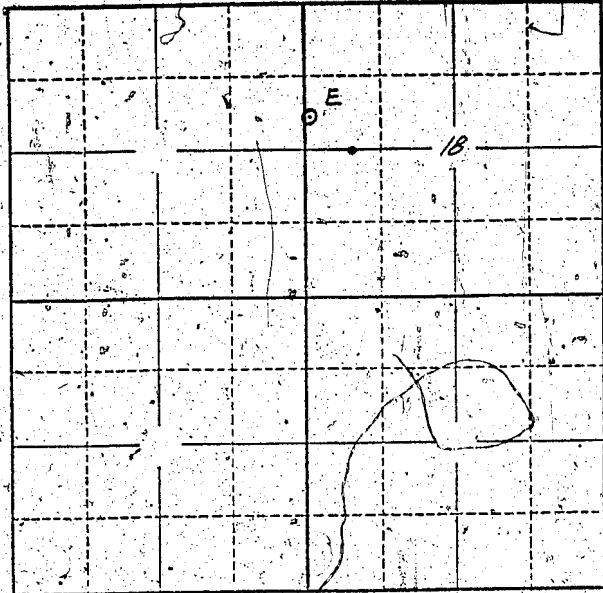

Locate well and acreage of irrigated land on plat.
Scale: 2" = 1 Mile

STATE OF OREGON

County of Linn } ss.

I, P. L. TURNIDGE, being first duly sworn, do hereby certify that I have read the foregoing Registration Statement and that all of the items therein contained are true to the best of my knowledge and belief.

P. L. Turnidge
(Signature of Registrant)

Subscribed and sworn to before me this 26th day of July, 1958.

My commission expires NOTARY PUBLIC FOR OREGON
My Commission Expires Sept. 29, 1959

Laura M. Johnson
(Notary Public)

(SEAL)

CERTIFICATE OF REGISTRATION

STATE OF OREGON

County of Marion } ss.

This is to certify that the foregoing Registration Statement was received in the office of the State Engineer on the 29 day of July, 1958, at 8:00 o'clock A. M. and has been duly recorded in said office in Book No. 12 of Registration Statements on page GR-2809

Witness my hand this 25th day of May, 1959

Lewis A. Stanley
(State Engineer)

By _____ (Deputy)

\$15⁰⁰