

# Registration Statement

## OF CLAIMANT OF RIGHT TO APPROPRIATE GROUND WATER

Well # 1

TO THE STATE ENGINEER OF OREGON:

I, Lester E. Talbott and Marie A. Talbott

of Rt. 3, Junction City County of Benton

State of Oregon, do hereby make application for a certificate of registration as evidence of a right to appropriate ground water.

1. Source from which water is withdrawn is Pump Well  
(Flowing well, pump well, infiltration trench, or tunnel)

2. Location is: 4 miles E. of Monroe, Oregon on Ingram Island  
(Approximate distance and direction from nearest city or town)

and is more particularly described as follows:

(a) ~~XXXXXX~~ N. 1940' E. 1410' of the S. W. corner  
(Give distance and bearing to corner of section or other legal subdivision)

being within NE<sup>1</sup>/<sub>4</sub> SW<sup>1</sup>/<sub>4</sub> of Sec. 30, Twp. 14 S, Rge. 4 W  
(Smallest legal subdivision) (N. or S.) (E. or W.)

or (b) within limits of recorded platted property, town or city:

in Lot \_\_\_\_\_, Block \_\_\_\_\_ of \_\_\_\_\_  
(Name of plat or addition)

County of \_\_\_\_\_  
(If within city or town, give name)

3. Construction Work was begun on 1941; was completed on 1941  
(Date) (Date)

and the ground water claimed was first used for the purposes set out below on 1941  
(Date)

since which time the water has been used intermittently  
(Continuously or Intermittently)

from May to October each year  
(Date) (Date)

4. Quantity of water claimed and used is 420 gallons per minute; 40 acre feet per year.

5. Purpose or Purposes for which water is used irrigation

(Domestic, irrigation, municipal, manufacturing, industrial, etc.)

6. Description of Well: Depth 24 feet. Type driven  
(Dug or drilled)

diameter 4 inches. Elevation of ground at well site 280 feet, mean sea level.  
(As near as known)

Depth to water table 12 feet approximately

7. Capacity of Well: \_\_\_\_\_ g.p.m. with \_\_\_\_\_ feet drawdown.

\_\_\_\_\_ g.p.m. with \_\_\_\_\_ feet drawdown.

Date of test Not tested

If Flowing Well: Measured discharge \_\_\_\_\_ g.p.m. on \_\_\_\_\_  
(Date)


Shut-in pressure at ground surface \_\_\_\_\_ lbs. per sq. in. on \_\_\_\_\_  
(Date)

Water is controlled by \_\_\_\_\_  
(Cap, valve, etc.)





See attached map  
Township 14S Range 4W, W.M.  
North

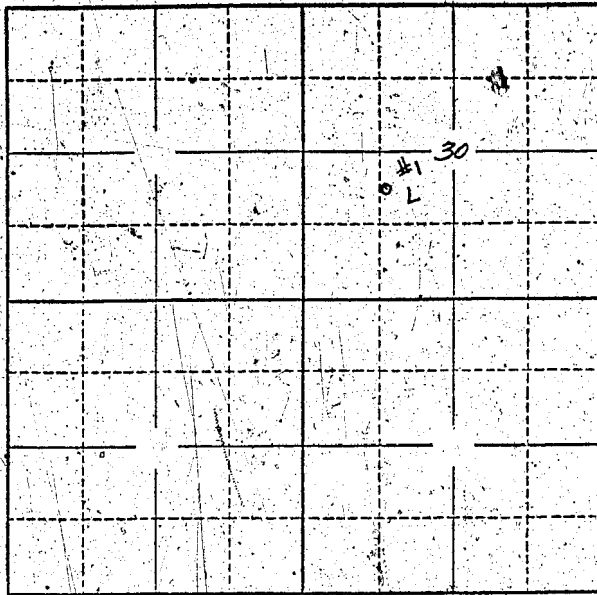

Locate well and acreage of irrigated land on plat.  
Scale: 2" = 1 Mile

STATE OF OREGON

County of Linn } ss.

I, Lester E. and Marie A. Talbot, being first duly sworn, do hereby certify that I have read the foregoing Registration Statement and that all of the items therein contained are true to the best of my knowledge and belief.

Lester E. Talbot Marie A. Talbot  
Lester E. Talbot Marie A. Talbot  
(Signature of Registrant)

Subscribed and sworn to before me this 28th day of July, 1958

My commission expires August 13, 1958

Wm. W. Deeg  
(Notary Public)

(SEAL)

**CERTIFICATE OF REGISTRATION**

STATE OF OREGON } ss.  
County of Marion

This is to certify that the foregoing Registration Statement was received in the office of the State Engineer on the 29 day of July, 1958 at 8:00 o'clock A. M. and has been duly recorded in said office in Book No. 12 of Registration Statements on page GR-2812

Witness my hand this 25th day of May, 1959

Lewis A. Stanley  
(State Engineer)

By \_\_\_\_\_ (Deputy)

\$15.00