

# Registration Statement

## OF CLAIMANT OF RIGHT TO APPROPRIATE GROUND WATER

Well # 2

### TO THE STATE ENGINEER OF OREGON:

I, Lester E. and Marie A. Talbott

of Rt. 3, Junction City County of Benton  
(Mailing address)

State of Oregon, do hereby make application for a certificate of registration as evidence of a right to appropriate ground water.

1. Source from which water is withdrawn is Pump well  
(Flowing well, pump well, infiltration trench, or tunnel)

2. Location is: 4 miles E. of Monroe, Oregon on Ingram Island  
(Approximate distance and direction from nearest city or town)

and is more particularly described as follows:

(a) N. 1095' E. 1595' of the S. W. Corner  
(Give distance and bearing to corner of section or other legal subdivision)

being within SE $\frac{1}{4}$  SW $\frac{1}{4}$  of Sec. 30, Twp. 14 S, Rge. 4 W  
(Smallest legal subdivision) (N. or S.) (E. or W.)

or (b) within limits of recorded platted property, town or city:

in Lot \_\_\_\_\_, Block \_\_\_\_\_ of \_\_\_\_\_  
(Name of plat or addition)

County of \_\_\_\_\_  
(If within city or town, give name)

3. Construction Work was begun on 1938; was completed on 1938  
(Date) (Date)

and the ground water claimed was first used for the purposes set out below on 1938  
(Date)

since which time the water has been used intermittently  
(Continuously or intermittently)

from May to October each year  
(Date) (Date)

4. Quantity of water claimed and used is 210 420 gallons per minute; 20 acre feet per year.

5. Purpose or Purposes for which water is used Irrigation

(Domestic, irrigation, municipal, manufacturing, industrial, etc.)

6. Description of Well: Depth 24 feet. Type driven  
(Dug or drilled)

diameter 2 - 2 $\frac{1}{2}$ " pipes. Elevation of ground at well site 280 feet, mean sea level.  
(As near as known)

Depth to water table 12 feet.

7. Capacity of Well: \_\_\_\_\_ g.p.m. with \_\_\_\_\_ feet drawdown.

\_\_\_\_\_ g.p.m. with \_\_\_\_\_ feet drawdown.

Date of test None made

If Flowing Well: Measured discharge \_\_\_\_\_ g.p.m. on \_\_\_\_\_  
(Date)

Shut-in pressure at ground surface \_\_\_\_\_ lbs. per sq. in. on \_\_\_\_\_  
(Date)

Water is controlled by \_\_\_\_\_  
(Cap, valve, etc.)

8. Casing: (Give diameter, commercial specifications and depth below ground surface of each casing size.)

..... inch diameter ..... from ..... to ..... feet  
..... inch diameter ..... from ..... to ..... feet  
..... inch diameter ..... from ..... to ..... feet  
..... inch diameter ..... from ..... to ..... feet

Describe and show depth of shoe, plug, adapter, liner or other details:  
.....  
.....

9. Perforated Casings or Screens:

STANDARD PERFORATION ..... from 18 to 22  
(Number per foot and size of perforations, or describe screen)  
..... from ..... to .....  
..... from ..... to .....  
..... from ..... to .....

10. Log of Well: (Describe each stratum or formation clearly, indicate if water bearing, and give thickness and depth as indicated.)

MATERIAL	Thickness (Feet)	Depth to Bottom (Feet)

If log of well is not available, give name and address of driller.

11. Infiltration Trench: Covered or open

Dimensions: Length ft. Minimum depth ft. Maximum depth ft.

Bottom width ft. Discharge g.p.m. Date of test

12. Tunnel: Type of lining

Dimensions: (Length, course, and cross sectional size)

Position of water bearing stratum with reference to portal of tunnel

Log of tunnel: (Preceding table for log of well may be used, if desired. Give footage from portal and character of materials, as pertinent.)

13. Pumping Equipment:

(a) Pump BERTELEY CENTRIFUGAL 3" Capacity 525 g.p.m. (Make, type and size)

(b) Motor John Deere Model BB 15HP (Type and horsepower)


14. Location of area irrigated or to be irrigated, or place of use if for purposes other than irrigation.

Table with 6 columns: Township North or South, Range E. or W. of Willamette Meridian, Section, Forty-acre Tract, Number Acres To Be Irrigated, Date of Reclamation. Contains 4 rows of data with handwritten entries.

15. If the ground water supply is supplemental to an existing water supply, identification of any application for a permit, permit, certificate or adjudicated right to appropriate water made or held by the registrant.

See attached map

Township 145 Range 4W W.M.  
North

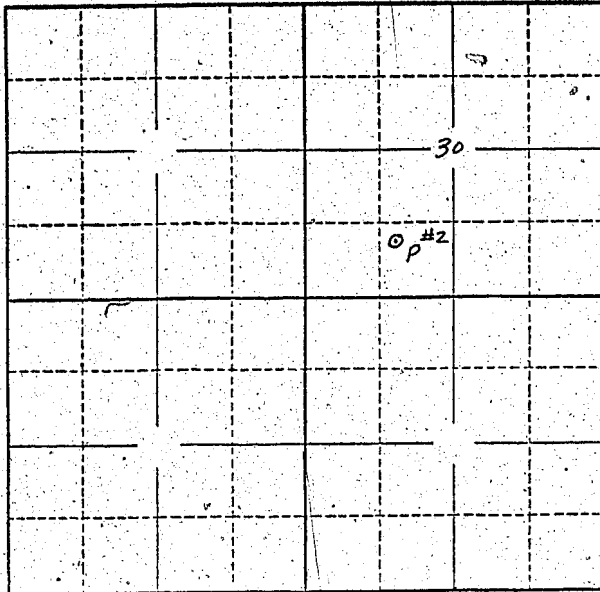

Locate well and acreage of irrigated land on plat.  
Scale: 2" = 1 Mile

STATE OF OREGON

County of ~~Wasco~~ Linn } ss.

I, Lester E. and Marie A. Talbott being first duly sworn, do hereby certify that I have read the foregoing Registration Statement and that all of the items therein contained are true to the best of my knowledge and belief.

Lester E. Talbott Marie A. Talbott  
Lester E. Talbott Marie A. Talbott  
(Signature of Registrant)

Subscribed and sworn to before me this 28th day of July, 1958

My commission expires August 13, 1958

Walter L. ...  
(Notary Public)

(SEAL)

**CERTIFICATE OF REGISTRATION**

STATE OF OREGON

County of Marion } ss.

This is to certify that the foregoing Registration Statement was received in the office of the State Engineer on the 29 day of July, 1958, at 8:00 o'clock A. M. and has been duly recorded in said office in Book No. 12 of Registration Statements on page GR 2813

Witness my hand this 25<sup>th</sup> day of May, 1959

Laura A. Stanley  
(State Engineer)  
By \_\_\_\_\_  
(Deputy)

\$15.00