

Registration Statement

OF CLAIMANT OF RIGHT TO APPROPRIATE GROUND WATER

TO THE STATE ENGINEER OF OREGON:

I, WE, THEODORE B. STONE and LENORE J. STONE, husband and wife, of Route 3, Box 94-A, Newberg, Oregon, do hereby make application for a certificate of registration as evidence of a right to appropriate ground water.

1. Source from which water is withdrawn is pump well (Flowing well, pump well, infiltration trench, or tunnel)

2. Location is: approximately three miles Northwest of Newberg on a cross road about 1/4 mile North of State Highway 240 (South Valley Road) and is more particularly described as follows: 780 feet North & 1900 feet East from SW Corner Section 11

(a) See attached Schedule "A" being within Southeast quarter of the Southwest quarter of Sec. 11, Twp. 3 South, Rge. 3 West

or (b) within limits of recorded property, town or city: in Lot, Block of County of

3. Construction Work was begun on August 5, 1950; was completed on August 29, 1950

and the ground water claimed was first used for the purposes set out below on August 29, 1950

since which time the water has been used continuously from August 29, 1950 to the present time.

4. Quantity of water claimed and used is 25 gallons per minute; acre feet per year.

5. Purpose or Purposes for which water is used: ~~domestic~~ irrigation

6. Description of Well: Depth 69 feet. Type Drilled diameter 10 inches. Elevation of ground at well site estimated 150 feet, mean sea level

Depth to water table approx. 16 feet. static head, approx. 20 feet working head

7. Capacity of Well: 25 g.p.m. with 4 feet drawdown. approx. g.p.m. with feet drawdown.


Date of test August 29, 1950

If Flowing Well: Measured discharge g.p.m. on

Shut-in pressure at ground surface lbs. per sq. in. on

Water is controlled by (Cap, valve, etc.)

Township 3 S Range 3 W W.M. North

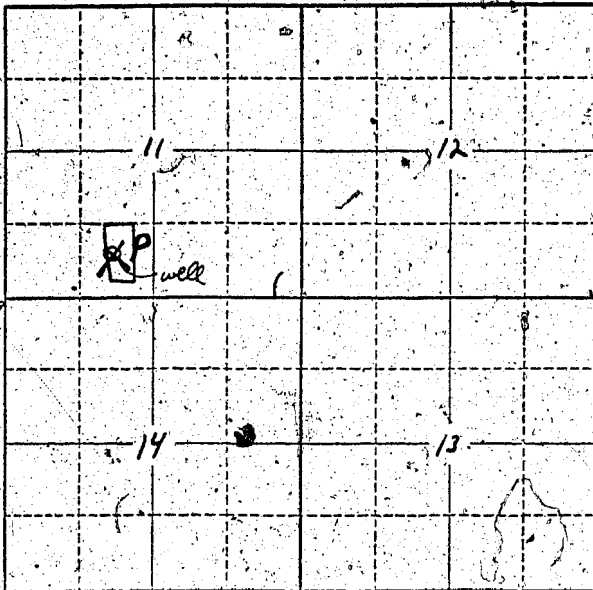

Locate well and acreage of irrigated land on plat.
Scale: 2" = 1 Mile.

STATE OF OREGON

County of Yamhill

WE THEODORE B. STONE and LEMORE J. STONE, each being first duly sworn, do hereby certify that I have read the foregoing Registration Statement and that all of the items therein contained are true to the best of my knowledge and belief.

Theodore B. Stone
Lemore J. Stone
(Signature of Registrant)

Subscribed and sworn to before me this 27th day of July, 19 58

My commission expires 11/15/61

Robert J. Huff
(Notary Public)

(SEAL)

CERTIFICATE OF REGISTRATION

STATE OF OREGON

County of Marion

This is to certify that the foregoing Registration Statement was received in the office of the State Engineer on the 29 day of July, 19 58, at 8:00 o'clock A.M. and has been duly recorded in said office in Book No. 12 of Registration Statements on page GR-2818

Witness my hand this 25th day of May, 19 59

Lawrence A. Stanley
(State Engineer)

By _____ (Deputy)

\$1500