

Registration Statement

REGISTRATION NO. GR-3014CERTIFICATE NO. GR-3032

OF CLAIMANT OF RIGHT TO APPROPRIATE GROUND WATER

(Under Chapter 708, Oregon Laws 1955.)

TO THE STATE ENGINEER OF OREGON:

I, CLIFFORD P. WHALENof The Dalles County of WascoState of Oregon, do hereby make application for a certificate of registration as evidence of a right to appropriate ground water.1. Source from which water is withdrawn is Dug Well
(Flowing well, pump well, infiltration trench, or tunnel)2. Location is: Approximately 7 miles Southerly of The Dalles, Oregon
(Approximate distance and direction from nearest city or town)

and is more particularly described as follows:

(a) (See copy of legal description of well site attached)
(Give distance and bearing to corner of section or other legal subdivision)being within the NE of Sec. 23, Twp. 1 North, Rge. 12 East, W.M.
(Small legal subdivision) (N, or S.) (E, or W.)

or (b) within limits of recorded platted property, town or city:

in Lot _____, Block _____ of _____
(Name of plat or addition)County of _____
(If within city or town, give name)

1922

3. Construction Work was begun or in the fall of; was completed in the fall of 1922
(Date) (Date)and the ground water claimed was first used for the purposes set out below in spring of 1923
(Date)since which time the water has been used continuously
(Continuously or intermittently)from 1923 to date
(Date) (Date)4. Quantity of water claimed and used is approx. 50 gallons per minute; _____ acre feet per year.5. Purpose or Purposes for which water is used irrigation

(Domestic, irrigation, municipal, manufacturing, industrial, etc.)

6. Description of Well: Depth seven feet. Type dug
(Dug or drilled)diameter approx. 120 inches. Elevation of ground at well site approx. 500 feet, mean sea level.
(As near as known)Depth to water table 3 feet.7. Capacity of Well: 40 g.p.m. with complete drawdown in approx. 16 hours
of pumping
_____ g.p.m. with _____ feet drawdown.

Date of test _____

If Flowing Well: Measured discharge _____ g.p.m. on _____
(Date)Shut-in pressure at ground surface _____ lbs. per sq. in. on _____
(Date)Water is controlled by _____
(Cap, valve, etc.)

8. Casing: (Give diameter, commercial specifications and depth below ground surface of each casing size.)

None

..... inch diameter from to feet
 inch diameter from to feet
 inch diameter from to feet
 inch diameter from to feet

Describe and show depth of shoe, plug, adapter, liner or other details:

9. Perforated Casings or Screens:

..... from to
 (Number per foot and size of perforations, or describe screen)
 from to
 from to
 from to

10. Log of Well: (Describe each stratum or formation clearly, indicate if water bearing, and give thickness and depth as indicated.)

MATERIAL	Thickness (Feet)	Depth to Bottom (Feet)
None available		

If log of well is not available, give name and address of driller. This well was dug by hand

11. Infiltration Trench: Covered or open
 Dimensions: Length ft. Minimum depth ft. Maximum depth ft.
 Bottom width ft. Discharge g.p.m. Date of test

12. Tunnel: Type of lining
 Dimensions: (Length, course, and cross sectional size)
 Position of water bearing stratum with reference to portal of tunnel

Log of tunnel: (Preceding table for log of well may be used, if desired. Give footage from portal and character of materials, as pertinent.)

13. Pumping Equipment:
 (a) Pump Myers 2" pump Capacity 40 g.p.m.
 (b) Motor 3 horse electric

14. Location of area irrigated or to be irrigated, or place of use if for purposes other than irrigation.


Township North or South	Range E. or W. of Willamette Meridian	Section	Forty-acre Tract	Number Acres To Be Irrigated	Date of Reclamation
1 North	12 East	14	SW 1/4	10.0	1923
1 North	12 East	14	SW 1/4	10.0	
				Total 10.0	

Note: Legal description of real property is as follows:

"A tract of land beginning at a point situated 20.50 chains North, and 12.37 chains East of the Southeast corner of East 2/3 of W 2 of Colwell Donation Land Claim from which book scribed "H.N.E. Cor. b. T." bears S (62°43' E.) 46.2 links; thence N. (73°30' E.) 2. chains; E. (65°32' E.) 7.59 chains; N. (30°17') 18.15 chains; west 9.095 chains; S. (18°26' E.) 16.35 chains; S. (47°55' E.) 2 chains; S. (55.15' E) 3.80 chains to place of beginning, containing 14 acres." (all in Township 1 North, Range 12 East, W.M., Wasco County, Oregon.)

15. If the ground water supply is supplemental to an existing water supply, identification of any application for a permit, permit, certificate or adjudicated right to appropriate water made or held by the registrant.

Township 1 North Range 12 East, W.M.
North

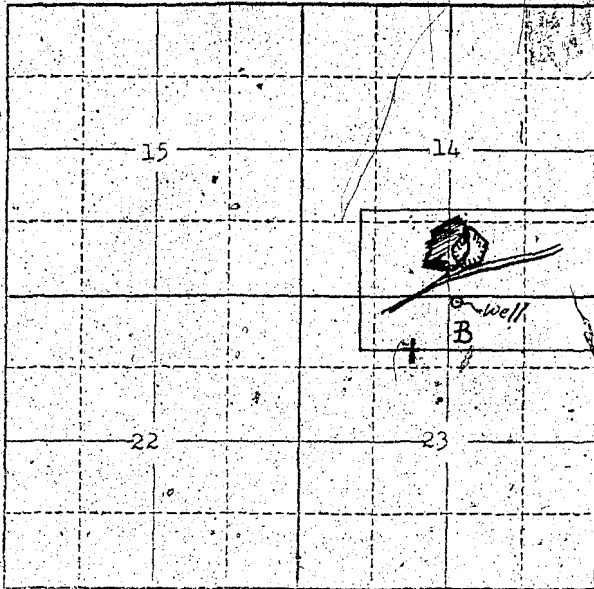

Locate well and acreage of irrigated land on plat.
Scale: 2" = 1 Mile

STATE OF OREGON

County of Wasco

ss.

I, Clifford P. Whalen, being first duly sworn, do hereby certify that I have read the foregoing Registration Statement and that all of the items therein contained are true to the best of my knowledge and belief.

Clifford P. Whalen
(Signature of Registrant)

Subscribed and sworn to before me this 25th day of July 1958.

My commission expires January 15, 1962.

Donald E. Keiler
(Notary Public)

(SEAL)

CERTIFICATE OF REGISTRATION

STATE OF OREGON

County of Marion

ss.

This is to certify that the foregoing Registration Statement was received in the office of the State Engineer on the 29 day of July 1958 at 1:00 o'clock P.M. and has been duly recorded in said office in Book No. 16 of Registration Statements on page GR-3932

Witness my hand this 15th day of February 1960

Laura A. Steiner
(State Engineer)

By

GR-3932

(Deputy)

#1522