

# Registration Statement

## OF CLAIMANT OF RIGHT TO APPROPRIATE GROUND WATER

TO THE STATE ENGINEER OF OREGON:

I, Ray Kelly & Elsie V. Kelly  
of Rt 2 Box 37 Milton Freewater County of Umatilla  
(Mailing address)

State of Oregon, do hereby make application for a certificate of registration as evidence of a right to appropriate ground water.

1. Source from which water is withdrawn is pump well  
(Flowing well, pump well, infiltration trench, or tunnel)

2. Location is: 3 miles west of Milton Freewater  
(Approximate distance and direction from nearest city or town)

and is more particularly described as follows:  
(a) 2620 feet (including angles) N.W. of section corner common to  
(Give distance and bearing to corner of section or other legal subdivision) 1023 1952 W  
being within S.W. 1/4 of S.E. 1/4 of Sec. 33, Twp. 6 N. Rge. 35 E.  
(Smallest legal subdivision) (N. or S.) (E. or W.) 3-9-33-34

or (b) within limits of recorded platted property, town or city:

in Lot \_\_\_\_\_, Block \_\_\_\_\_ of \_\_\_\_\_  
(Name of plat or addition)  
County of \_\_\_\_\_  
(If within city or town, give name)

3. Construction Work was begun on Prior to 1927, was completed on \_\_\_\_\_  
(Date)

and the ground water claimed was first used for the purposes set out below on Prior to 1927  
(Date)

since which time the water has been used Continuously  
(Continuously or Intermittently)  
from May 1st to Oct. 1st  
(Date) (Date)

4. Quantity of water claimed and used is 160 gallons per minute; 100 acre feet per year.

5. Purpose or Purposes for which water is used Irrigation  
(Domestic, irrigation, municipal, manufacturing, industrial, etc.)

6. Description of Well: Depth 63 feet. Type Dug  
(Dug or drilled)  
diameter 5 foot inches. Elevation of ground at well site 880 feet, mean sea level.  
(As near as known)  
Depth to water table 20 feet.

7. Capacity of Well: 160 g.p.m. with 10 feet drawdown.  
\_\_\_\_\_ g.p.m. with \_\_\_\_\_ feet drawdown.

Date of test \_\_\_\_\_

If Flowing Well: Measured discharge \_\_\_\_\_ g.p.m. on \_\_\_\_\_  
(Date)

Shut-in pressure at ground surface \_\_\_\_\_ lbs. per sq. in. on \_\_\_\_\_  
(Date)

Water is controlled by \_\_\_\_\_  
(Cap, valve, etc.)






SE 1/4 of Sec. 33

Center  
33

Township 6 N. Range 35 E. W.M.  
North

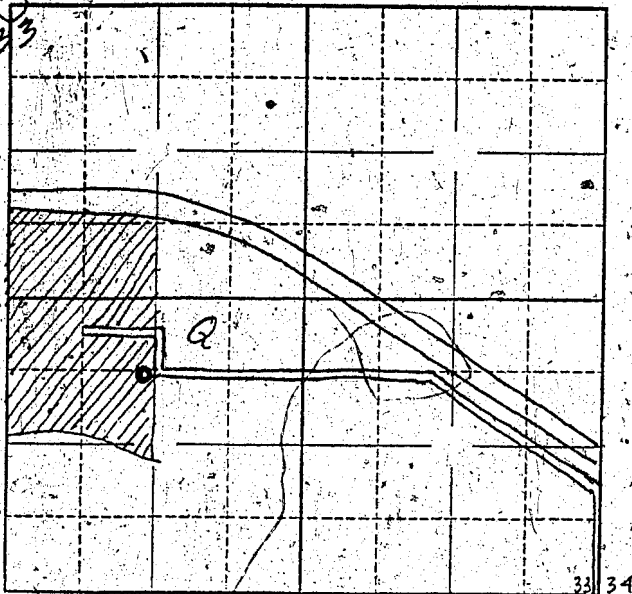

Locate well and acreage of irrigated land on plat. 7.3

Scale: 8" = 1 Mile

STATE OF OREGON

County of Washington ss.

I, Ray D. Kelly, being first duly sworn, do hereby certify that I have read the foregoing Registration Statement and that all of the items therein contained are true to the best of my knowledge and belief.

Ray D. Kelly  
(Signature of Registrant)

Subscribed and sworn to before me this 21 day of June, 1958

My commission expires 10/6/1975

(Notary Public)

(SEAL)

CERTIFICATE OF REGISTRATION

STATE OF OREGON }  
County of Marion } ss.

This is to certify that the foregoing Registration Statement was received in the office of the State Engineer on the 29 day of July, 1958, at 1:00 o'clock P. M. and has been duly recorded in said office in Book No. 12 of Registration Statements on page GR-2824

Witness my hand this 25<sup>th</sup> day of May, 1959

Clara A. Stanley  
(State Engineer)

By \_\_\_\_\_ (Deputy)

GR-2824

\$15.00