

# Registration Statement

## OF CLAIMANT OF RIGHT TO APPROPRIATE GROUND WATER

TO THE STATE ENGINEER OF OREGON:

I, Ed Means  
of Milton Freewater County of Umatilla  
(Mailing address)

State of Oregon, do hereby make application for a certificate of registration as evidence of a right to appropriate ground water.

1. Source from which water is withdrawn is Well Pump  
(Flowing well, pump well, infiltration trench, or tunnel)

2. Location is: 1/2 mile West of Freewater  
(Approximate distance and direction from nearest city or town)

and is more particularly described as follows: 282' S. 9 1/4' E From NW corner SW 1/4 SW 1/4

(a) 48 feet from South line of lot  
(Give distance and bearing to corner of section or other legal subdivision)

being within SW 1/4 SW 1/4 of Sec. 35, Twp. N, Rge. E  
(Smallest legal subdivision) (R or S.) (R or S.)

or (b) within limits of recorded platted property, town or city:

in Lot \_\_\_\_\_, Block \_\_\_\_\_ of \_\_\_\_\_  
(Name of plat or addition)

County of \_\_\_\_\_  
(If within city or town, give name)

3. Construction Work was begun on Feb 1 1903; was completed on March 20 1903  
(Date) (Date)

and the ground water claimed was first used for the purposes set out below on that date, 1903  
(Date)

since which time the water has been used Continuously  
(Continuously or intermittently)

from March to September each year  
(Date) (Date)

4. Quantity of water claimed and used is 40 gallons per minute; \_\_\_\_\_ acre feet per year.

5. Purpose or Purposes for which water is used Irrigation  
(Domestic, irrigation, municipal, manufacturing, industrial, etc.)

6. Description of Well: Depth 40 feet. Type Dug  
(Dug or drilled)

diameter 4 x 1 1/2 inches. Elevation of ground at well site 900± feet, mean sea level.  
(As near as known)

Depth to water table 8 feet in irrigation season

7. Capacity of Well: \_\_\_\_\_ g.p.m. with \_\_\_\_\_ feet drawdown.

6 g.p.m. with 8 feet drawdown. No Test

Date of test No Test

If Flowing Well: Measured discharge \_\_\_\_\_ g.p.m. on \_\_\_\_\_  
(Date)


Shut-in pressure at ground surface \_\_\_\_\_ lbs. per sq. in. on \_\_\_\_\_  
(Date)

Water is controlled by Springer pressure  
(Cap, valve, etc.)





Township 6 N Range 35 E, W.M.  
North

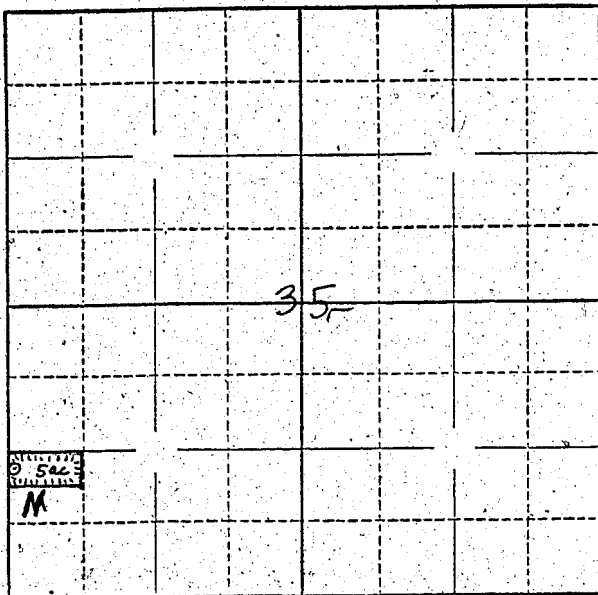

Locate well and acreage of irrigated land on plat.

Scale: ~~4~~ - 1 Mile  
4'

STATE OF OREGON

County of Marion

} ss.

I, \_\_\_\_\_, being first duly sworn, do hereby certify that I have read the foregoing Registration Statement and that all of the items therein contained are true to the best of my knowledge and belief.

[Signature]  
(Signature of Registrant)

Subscribed and sworn to before me this 29th day of July, 1958.

My commission expires 12 June 1961.

Wm. S. Bartholomew  
(Notary Public)

(SEAL)

**CERTIFICATE OF REGISTRATION**

STATE OF OREGON

County of Marion

} ss.

This is to certify that the foregoing Registration Statement was received in the office of the State Engineer on the 29th day of July, 1958, at 8:00 o'clock A.M. and has been duly recorded in said office in Book No. 12 of Registration Statements on page GR-2828

Witness my hand this 25th day of May, 1959.

Lewis A. Stanley  
(State Engineer)

By \_\_\_\_\_  
(Deputy)

GR - 2828

15.00