

Registration Statement

OF CLAIMANT OF RIGHT TO APPROPRIATE GROUND WATER

TO THE STATE ENGINEER OF OREGON:

I, Roy St. or Clara M Dunn
 of Route 2 Box 253 Silverton Marion County of Oregon
 (Mailing address) State of Oregon, do hereby make application for a certificate of registration as evidence of a right to appropriate ground water.

1. Source from which water is withdrawn is Pump well
 (Flowing well, pump well, infiltration trench, or tunnel)
2. Location is: 7 miles nw of Silverton Oregon
 (Approximate distance and direction from nearest city or town)

and is more particularly described as follows:

- (a) 1730' N 52° 0' W from the SE Cor. Sec. 24 T 6 S R 2 W
 (Give distance and bearing to corner of section or other legal subdivision)
 being within SW 1/4 of the SE 1/4 of Sec. 24, Twp. 6 S, Rge. 2 W
 (Smallest legal subdivision) (S. or S.) (S. or W.)
- or (b) within limits of recorded platted property, town or city:
 in Lot _____, Block _____ of _____
 (Name of plat or addition)

(If within city or town, give name) Marion County of _____

3. Construction Work was begun on June 1955; was completed on June 11, 1955
 (Date) (Date)
- and the ground water claimed was first used for the purposes set out below on June 1955
 (Date)
- since which time the water has been used continuously intermittently during season
 (Continuously or intermittently)
- from June 11 to date
 (Date) (Date)

4. Quantity of water claimed and used is 160 gallons per minute; _____ acre feet per year.

5. Purpose or Purposes for which water is used irrigation

(Domestic, irrigation, municipal, manufacturing, industrial, etc.)

6. Description of Well: Depth 140 feet. Type drilled
 (Dug or drilled)
- diameter 8 inches. Elevation of ground at well site 139 feet, mean sea level.
 (As near as known)
- Depth to water table 37 feet.

7. Capacity of Well: 165 g.p.m. with 56 feet drawdown.
540 g.p.m. with 77 feet drawdown.

Date of test June 16, 1955

If Flowing Well: Measured discharge _____ g.p.m. on _____
 (Date)

Shut-in pressure at ground surface _____ lbs. per sq. in. on _____
 (Date)

Water is controlled by _____
 (Cap, valve, etc.)

8 inch diameter steel casing from top to 141 feet

inch diameter from to feet

inch diameter from to feet

inch diameter from to feet

40 rows of eight cuts per row	from 112	to 141
(Number per foot and size of perforations, or describe screen)		
	from	to
	from	to
	from	to
	from	to

[illegible]

If log of well is not available, give name and address of driller. Max. W. Moore Sal.

11. Infiltration Trench: Covered or open

Dimensions: Length ft. Minimum depth ft. Maximum depth ft.

Bottom width ft. Discharge g.p.m. Date of test

12. Tunnel: Type of lining

Dimensions:
(Length, course, and cross sectional size)

Position of water bearing stratum with reference to portal of tunnel

Log of tunnel: (Preceding table for log of well may be used, if desired. Give footage from portal and character of materials, as pertinent.)

13. Pumping Equipment:

(a) Pump Jacuzzi turbine 10 hp Capacity 195 g.p.m.
(Make, type and size)


(b) Motor Electric 1/2 hp
(Type and horsepower)

14. Location of area irrigated or to be irrigated, or place of use if for purposes other than irrigation.

Township North or South	Range E. or W. of Willamette Meridian	Section	Forty-acre Tract	Number Acres To Be Irrigated	Date of Reclamation
6 S	2 W	24	SE 1/4 of the SE 1/4	14.5	June 1955
6 S	2 W	24	SW 1/4 of the SE 1/4	15.5	" "
				30.0	
			Property irrigated on Conrad Gunderson Farm		
6 S	2 W	24	NW 1/4 of the SE 1/4	4.1	June 1955
6 S	2 W	24	NE 1/4 of the SE 1/4	2.9	" "
				7.0	
				Total 37.0	" "

15. If the ground water supply is supplemental to an existing water supply, identification of any application for a permit, permit, certificate or adjudicated right to appropriate water made or held by the registrant.

Township 6S Range 2W, W.M.
North

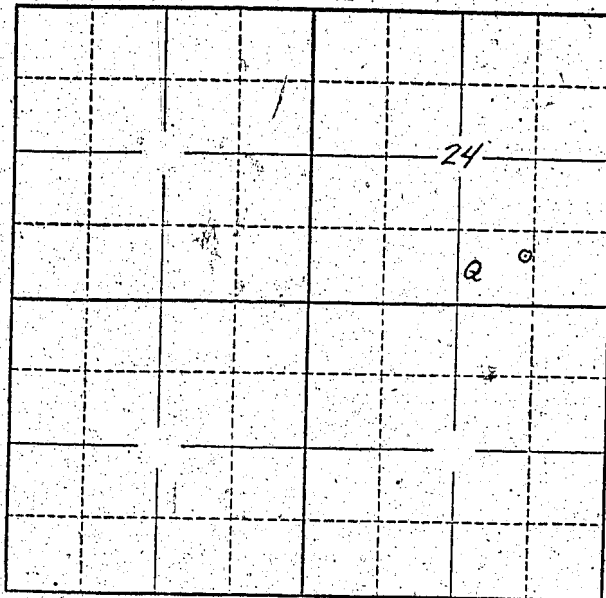

Locate well and acreage of irrigated land on plat.
Scale: 2" = 1 Mile

STATE OF OREGON

County of Marion } ss.

I, Roy F. Kinn, being first duly sworn, do hereby certify that I have read the foregoing Registration Statement and that all of the items therein contained are true to the best of my knowledge and belief.

Roy F. Kinn
(Signature of Registrant)

Subscribed and sworn to before me this 22 day of JULY, 1952

My commission expires 1-22-1962

W. D. B. Lunt
(Notary Public)

(SEAL)

CERTIFICATE OF REGISTRATION

STATE OF OREGON

County of Marion } ss.

This is to certify that the foregoing Registration Statement was received in the office of the State Engineer on the 29th day of July, 1952, at 2:00 o'clock P.M. and has been duly recorded in said office in Book No. 12 of Registration Statements on page GR-2841

Witness my hand this 25th day of May, 1959

Lewis A. Stanley
(State Engineer)

By _____
(Deputy)

GR - 2841