

Registration No. GR. 3042

Certificate No. GR. 2848

Registration Statement

OF CLAIMANT OF RIGHT TO APPROPRIATE GROUND WATER

TO THE STATE ENGINEER OF OREGON:

I, Ray McKibben

of R2 Box 499 Salem County of Marion

State of Oregon do hereby make application for a certificate of registration as evidence of a right to appropriate ground water.

1. Source from which water is withdrawn is Pump Well
(Flowing well, pump well, infiltration trench, or tunnel)

2. Location is: Approximately 7 1/2 miles N.E. of Salem
(Approximate distance and direction from nearest city or town)

and is more particularly described as follows:

(a) 1910' N 27° 25' E from the SW corner Sect. 35
(Give distance and bearing to corner of section or other legal subdivision)

being within SE4 NW4 SW4 of Sec. 35, Twp. 6 S, Rge. 2 W
(Smallest legal subdivision) (N. or S.) (E. or W.)

or (b) within limits of recorded platted property, town or city: None

in Lot _____, Block _____ of _____
(Name of plat or addition)

County of _____
(If within city or town, give name)

3. Construction Work was begun on May 1, 1954; was completed on May 20, 1954
(Date) (Date)

and the ground water claimed was first used for the purposes set out below on April 10, 1954
(Date)

since which time the water has been used Intermittently
(Continuously or Intermittently)

from April 1 to October 1
(Date) (Date)

4. Quantity of water claimed and used is 35 gallons per minute; _____ acre feet per year.

5. Purpose or Purposes for which water is used irrigation of pasture, corn and clover

(Domestic, irrigation, municipal, manufacturing, industrial, etc.)

6. Description of Well: Depth 111 feet. Type Drilled
(Dug or drilled)

diameter 8 inches. Elevation of ground at well site app. 190 ft. above sea level
(As near as known) feet, mean sea level.

Depth to water table 80 feet.

7. Capacity of Well: 200 g.p.m. with unknown feet drawdown.

_____ g.p.m. with _____ feet drawdown.

Date of test May 18, 1954


If Flowing Well: Measured discharge _____ g.p.m. on _____
(Date)

Shut-in pressure at ground surface _____ lbs. per sq. in. on _____
(Date)

Water is controlled by Valve
(Cap, valve, etc.)

SEE ATTACHED MAP

Township 6 S Range 2 W, W.M.
North

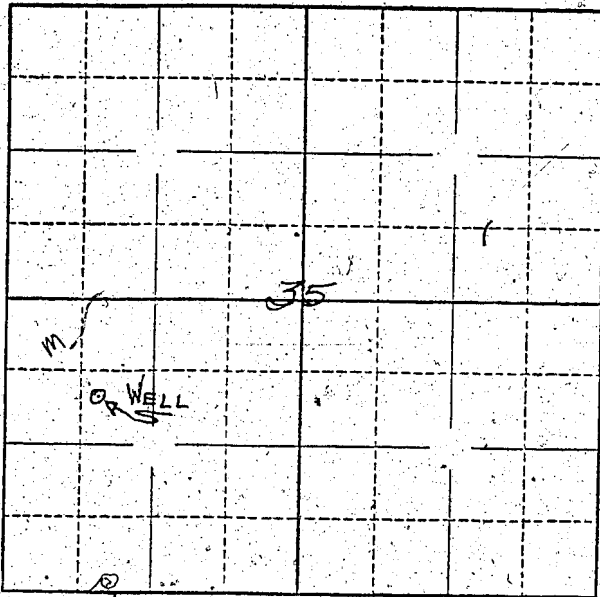

Locate well and acreage of irrigated land on plat.

Scale: 1" = 1 Mile

STATE OF OREGON

County of Marion } ss.

I, Ray McRibbe, being first duly sworn, do hereby certify that I have read the foregoing Registration Statement and that all of the items therein contained are true to the best of my knowledge and belief.

Ray McRibbe
(Signature of Registrant)

Subscribed and sworn to before me this 29th day of July, 1958.

My commission expires 12th June 1961

Wm. S. Bartholomew
(Notary Public)

(SEAL)

CERTIFICATE OF REGISTRATION

STATE OF OREGON

County of Marion } ss.

This is to certify that the foregoing Registration Statement was received in the office of the State Engineer on the 29th day of July, 1958, at 2:30 o'clock P.M. and has been duly recorded in said office in Book No. 12 of Registration Statements on page GR-2848

Witness my hand, this 25th day of May, 1959.

Alva A. Stanley
(State Engineer)

By _____
(Deputy)

GR-2848

\$15.00