

2745
RECEIVED
JUL 2 1958
STATE ENGINEER
SALEM, OREGON

REGISTRATION NO. GR-3046
CERTIFICATE NO. GR-2852

Registration Statement

OF CLAIMANT OF RIGHT TO APPROPRIATE GROUND WATER

(Under Chapter 708, Oregon Laws 1955.)

TO THE STATE ENGINEER OF OREGON:

I, Harmer Gouley
of Rt. 2, Box 217 Salem County of Marion

State of Oregon, do hereby make application for a certificate of registration as evidence of a right to appropriate ground water.

1. Source from which water is withdrawn is Pump Well
(Flowing well, pump well, infiltration trench, or tunnel)

2. Location is: 2 miles west of Brooks Ore.
(Approximate distance and direction from nearest city or town)

and is more particularly described as follows: 90° 51' 19" E 1/4 W from the E 1/4 Corner of Section 13

(a) (550' south & 1640' West of NE Property Corner)
(Give distance and bearing to corner of section or other legal subdivision)

being within NE 1/4 of SE 1/4 of Sec. 13, Twp. 6 S, Rge. 3 W
(Smallest legal subdivision) (N. or S.) (E. or W.)

(b) within limits of recorded platted property, town or city:

in Lot _____, Block _____ of _____
(Name of plat or addition)

County of Marion
(If within city or town, give name)

3. Construction Work was begun on Feb. 1952; was completed on Mar. 1952
(Date) (Date)

and the ground water claimed was first used for the purposes set out below on June 1952
(Date)

since which time the water has been used Continuously
(Continuously or intermittently)

from 1952 to Present
(Date) (Date)

4. Quantity of water claimed and used is 550 gallons per minute; 275 acre feet per year.

5. Purpose or Purposes for which water is used Irrigation - Hops, Pasture, grain
(Domestic, irrigation, municipal, manufacturing, industrial, etc.)

6. Description of Well: Depth 140 feet. Type Drilled
(Dug or drilled)

diameter 10 inches. Elevation of ground at well site 150 feet, mean sea level.
(As near as known)

Depth to water table 17 feet.

7. Capacity of Well: 600 g.p.m. with 4.5 feet drawdown.

_____ g.p.m. with _____ feet drawdown.

Date of test Mar. 1952

If Flowing Well: Measured discharge _____ g.p.m. on _____
(Date)

Shut-in pressure at ground surface _____ lbs. per sq. in. on _____
(Date)

Water is controlled by _____
(Cap, valve, etc.)

If log of well is not available, give name and address of driller. Fred Wymore

11. Infiltration Trench: Covered or open

Dimensions: Length _____ ft. Minimum depth _____ ft. Maximum depth _____ ft.

Bottom width _____ ft. Discharge _____ g.p.m. Date of test _____

12. Tunnel: Type of lining

Dimensions: _____
(Length, course, and cross sectional size)

Position of water bearing stratum with reference to portal of tunnel _____

Log of tunnel: (Preceding table for log of well may be used, if desired. Give footage from portal and character of materials, as pertinent.)

13. Pumping Equipment:

(a) Pump Universal Turbine Capacity 650 g.p.m.
(Make, type and size)


(b) Motor 2 D.M.P. G.E.
(Type and horsepower)

14. Location of area irrigated or to be irrigated, or place of use if for purposes other than irrigation.

Township North or South	Range E. or W. of Willamette Meridian	Section	Forty-acre Tract	Number Acres To Be Irrigated	Date of Reclamation
65	3W	13	SW 1/4 of NE 1/4	25.0	JUNE 1952
"	"	"	SE 1/4 " NE 1/4	15.0	"
"	"	"	NE 1/4 " SW 1/4	31.8	"
"	"	"	SE 1/4 " SW 1/4	1.2	"
"	"	"	NW 1/4 " SE 1/4	37.6	"
"	"	"	SW 1/4 " SE 1/4	1.0	"
"	"	"	NE 1/4 " SE 1/4	26.0	"
"	"	"	SE 1/4 " SE 1/4	0.6	"
				<u>138.2</u>	

15. If the ground water supply is supplemental to an existing water supply, identification of any application for a permit, permit, certificate or adjudicated right to appropriate water made or held by the registrant.

Township: 6S Range: 3W, W.M.
North

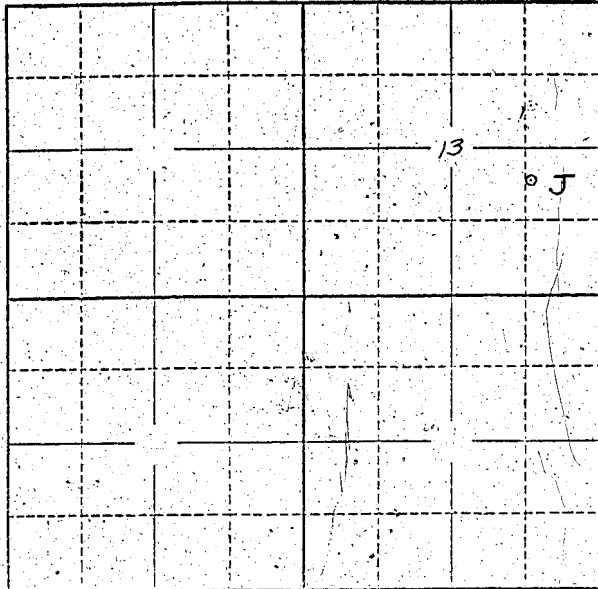

Locate well and acreage of irrigated land on plat.
Scale: 2" = 1 Mile

STATE OF OREGON }
County of Marion } ss.

I, Harold G. Gaylor, being first duly sworn, do hereby certify that I have read the foregoing Registration Statement and that all of the items therein contained are true to the best of my knowledge and belief.

Harold G. Gaylor
(Signature of Registrant)

Subscribed and sworn to before me this 29th day of July, 1958.

My commission expires May 25, 1959
(Notary Public)

(SEAL)

CERTIFICATE OF REGISTRATION

STATE OF OREGON }
County of Marion } ss.

This is to certify that the foregoing Registration Statement was received in the office of the State Engineer on the 29th day of July, 1958, at 4:15 o'clock P.M. and has been duly recorded in said office in Book No. 12 of Registration Statements on page GR-2852


Witness my hand this 25th day of May, 1959

Lewis A. Stanley
(State Engineer)

By _____
(Deputy)

#2745

GR-2852