

Registration No. GR - 3047

Certificate No. GR - 2853

Registration Statement**OF CLAIMANT OF RIGHT TO APPROPRIATE GROUND WATER****TO THE STATE ENGINEER OF OREGON:**

I, ALBERT JOSEPH PATZ,
 of 4795 SWEGLE ROAD County of MARION,
(Mailing address)

State of OREGON, do hereby make application for a certificate of registration as evidence
 of a right to appropriate ground water.

1. Source from which water is withdrawn is PUMP WELL #1
(Flowing well, pump well, infiltration trench, or tunnel)

2. Location is: SALEM OREGON
(Approximate distance and direction from nearest city or town)

and is more particularly described as follows:

(a) 4.2 chains east & 32.2 chains south from NW corner Section 20
(Give distance and bearing to corner of section or other legal subdivision)

being within SW 1/4 of N 1/4 of Sec. 20, Twp. 7S, Rge. 2W
(Smallest legal subdivision) (or S.) (or W.)

or (b) within limits of recorded platted property, town or city:

in Lot _____, Block _____ of _____
(Name of plat or addition)

(If within city or town, give name) County of _____

3. Construction Work was begun on MAY 1951, was completed on MAY 1951
(Date) (Date)

and the ground water claimed was first used for the purposes set out below on UNKNOWN 1951
(Date)

since which time the water has been used INTERMITTENTLY
(Continuously or Intermittently)

from 1951 to Oct. 1958
(Date) (Date)

4. Quantity of water claimed and used is 20 gallons per minute; _____ acre
 feet per year.

5. Purpose or Purposes for which water is used IRRIGATION

(Domestic, irrigation, municipal, manufacturing, industrial, etc.)

6. Description of Well: Depth 43 feet. Type DRIVEN
(Dug or drilled)

diameter 2 inches. Elevation of ground at well site _____ feet, mean sea level.
(As near as known)

Depth to water table 10 feet.

7. Capacity of Well: 1200 g.p.m. with 20 feet drawdown.

_____ g.p.m. with _____ feet drawdown.

Date of test UNKNOWN

If Flowing Well: Measured discharge _____ g.p.m. on _____
(Date)

Shut-in pressure at ground surface _____ lbs. per sq. in. on _____
(Date)

Water is controlled by _____
(Cap, valve, etc.)

8. **Casing:** (Give diameter, commercial specifications and depth below ground surface of each casing size.)

2	inch diameter	Pipe	from 0	to 43	feet
	inch diameter		from	to	feet
	inch diameter		from	to	feet
	inch diameter		from	to	feet

Describe and show depth of shoe, plug, adapter, liner or other details: _____

9. Perforated Casings or Screens:

16	(Number per foot and size of perforations, or describe screen)	from	to
		from	to
		from	to
		from	to

10. Log of Well: (Describe each stratum or formation clearly, indicate if water bearing, and give thickness and depth as indicated.)

[illegible]

unk.

11. Infiltration Trench: Covered or open

Dimensions: Length ft. Minimum depth ft. Maximum depth ft.

Bottom width ft. Discharge g.p.m. Date of test

12. Tunnel: Type of lining

Dimensions: _____
(Length, course, and cross sectional size)

Position of water bearing stratum with reference to portal of tunnel

Log of tunnel: (Preceding table for log of well may be used, if desired. Give footage from portal and character of materials, as pertinent.)

13. Pumping Equipment:

(a) Pump Centrifugal Universal Capacity 25 g.p.m.
(Make, type and size)


(h) Motor 3/4 HP Electric
(Type and horsepower)

14. Location of area irrigated or to be irrigated, or place of use if for purposes other than irrigation.

[illegible]

15. If the ground water supply is supplemental to an existing water supply, identification of any application for a permit, permit, certificate or adjudicated right to appropriate water made or held by the registrant.

Township 7S Range 2W, W.M.
North

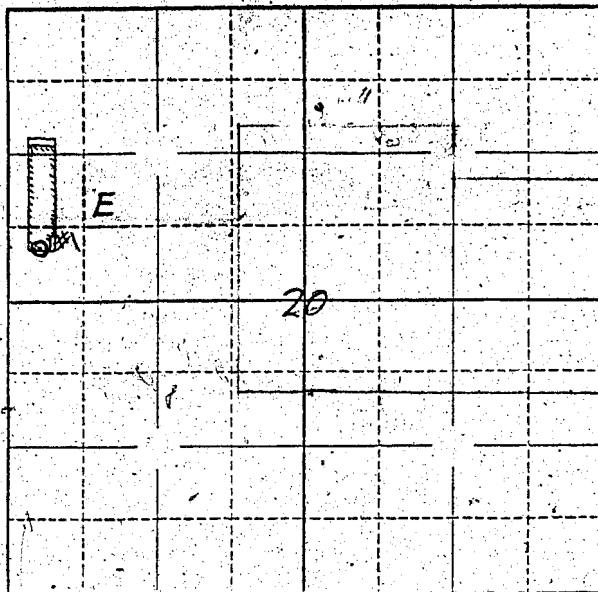

Locate well and acreage of irrigated land on plat.
Scale: 2" = 1 Mile

STATE OF OREGON

County of Marion

ss.

I, Albert J. Patz, being first duly sworn, do hereby certify that I have read the foregoing Registration Statement and that all of the items therein contained are true to the best of my knowledge and belief.

Albert J. Patz
(Signature of Registrant)

Subscribed and sworn to before me this 29th day of July, 1958

My commission expires 12th June 1961

Wm. S. Bartholomew
(Notary Public)

(SEAL)

CERTIFICATE OF REGISTRATION

STATE OF OREGON

County of Marion

ss.

A

This is to certify that the foregoing Registration Statement was received in the office of the State Engineer on the 29th day of July, 1958, at 4:40 o'clock P. M. and has been duly recorded in said office in Book No. 12 of Registration Statements on page GR 2853

Witness my hand this 25th day of May, 1959

Lewis A. Stanley
(State Engineer)

By

(Deputy)

\$ 15.00

GR - 2853