

# Registration Statement

## OF CLAIMANT OF RIGHT TO APPROPRIATE GROUND WATER

TO THE STATE ENGINEER OF OREGON:

I, A. R. Siegmund  
of 165.5 Lancaster, Salem County of Marion  
State of Oregon, do hereby make application for a certificate of registration as evidence  
of a right to appropriate ground water.

1. Source from which water is withdrawn is Pump Well  
(Flowing well, pump well, infiltration trench, or tunnel)
2. Location is: 5 Mi. East of Salem  
(Approximate distance and direction from nearest city or town)

and is more particularly described as follows:

(a) 1683' West + 264 feet South of NE Cor Sec 21  
(Give distance and bearing to corner of section or other legal subdivision)

being within NW 1/4 of NE 1/4 of Sec. 21, Twp. 7S, Rge. 2W  
(Smallest legal subdivision) (N. or S.) (E. or W.)

or (b) within limits of recorded platted property, town or city: Salem Ore

in Lot 1, Block of East Side Fruit Farms  
(Name of plat or addition)

County of Marion  
(If within city or town, give name)

3. Construction Work was begun on 1 June 1944 was completed on 1 July 1944  
(Date) (Date)

and the ground water claimed was first used for the purposes set out below on 1 July 1944  
(Date)

since which time the water has been used Continuously  
(Continuously or intermittently)

from 1 July 1944 to 60 14  
(Date) (Date)

4. Quantity of water claimed and used is 7000 gallons per minute; 14 acre  
feet per year.

5. Purpose or Purposes for which water is used Irrigation + watering green house plants  
(Domestic, irrigation, municipal, manufacturing, industrial, etc.) (Non-Commercial)

6. Description of Well: Depth 90.78 feet. Type Drilled  
(Dug or drilled)

diameter 8 inches. Elevation of ground at well site 150 feet, mean sea level.  
(As near as known)

Depth to water table 18 feet.

7. Capacity of Well: 60 g.p.m. with 0 feet drawdown. Unknown are pumping 60 g.p.m.  
g.p.m. with \_\_\_\_\_ feet drawdown.

Date of test None

If Flowing Well: Measured discharge \_\_\_\_\_ g.p.m. on \_\_\_\_\_  
(Date)

Shut-in pressure at ground surface \_\_\_\_\_ lbs. per sq. in. on \_\_\_\_\_  
(Date)

Water is controlled by \_\_\_\_\_  
(Cap. valve, etc.)

8. Casing: (Give diameter, commercial specifications and depth below ground surface of each casing size.)

8 inch diameter steel casing from 0 to <sup>90</sup>108 feet  
 inch diameter from to feet  
 inch diameter from to feet  
 inch diameter from to feet

Describe and show depth of shoe, plug, adapter, liner or other details:

9. Perforated Casings or Screens:


12 per ft 1/4" x 3" from <sup>70</sup>~~98~~ to <sup>90</sup>108  
(Number per foot and size of perforations, or describe screen)  
Unknown from to  
 from to  
 from to

10. Log of Well: (Describe each stratum or formation clearly, indicate if water bearing, and give thickness and depth as indicated.)

MATERIAL	Thickness (Feet)	Depth to Bottom (Feet)
Soil	18	90
Cemented Gravel (Some Water)	52	38
Gravel	20	18
Soil	18	72
Cemented Gravel (Some Water)	52	20
Gravel (Water bearing)	20	0



Township 7.5 Range 2W W.M.  
North

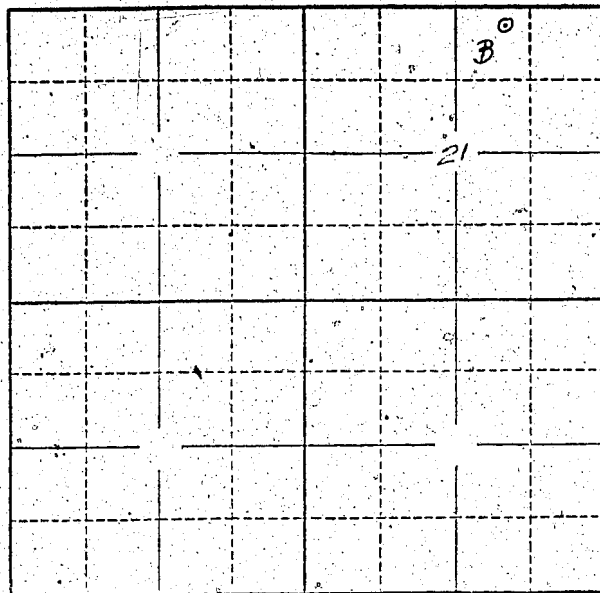

Locate well and acreage of irrigated land on plat.  
Scale: 2" = 1 Mile

STATE OF OREGON }  
County of Marion } ss.

I, A.R. Diegmann, being first duly sworn, do hereby certify that I have read the foregoing Registration Statement and that all of the items therein contained are true to the best of my knowledge and belief.

A.R. Diegmann  
(Signature of Registrant)

Subscribed and sworn to before me this 28th day of July, 1958

My commission expires 9/17/59  
Laurie M. Brown  
(Notary Public) for Oregon

(SEAL)

**CERTIFICATE OF REGISTRATION**

STATE OF OREGON }  
County of Marion } ss.

This is to certify that the foregoing Registration Statement was received in the office of the State Engineer on the 29th day of July, 1958, at 4:30 o'clock P. M. and has been duly recorded in said office in Book No. 12 of Registration Statements on page GR-2855

Witness my hand this 25th day of May

1959  
Laura J. Stanley  
(State Engineer)

By \_\_\_\_\_  
(Deputy)

\$15.00