

RECEIVED
MAY 10 1959

STATE ENGINEER
SALEM, OREGON

Registration Statement

REGISTRATION NO. GR-3052
CERTIFICATE NO. GR-4033

OF CLAIMANT OF RIGHT TO APPROPRIATE GROUND WATER

(Under Chapter 708, Oregon Laws 1955.)

RECEIVED
MAR 10 1960

STATE ENGINEER
SALEM, OREGON

TO THE STATE ENGINEER, OF OREGON:

I, Victor G. Stohens, City Superintendent
of City of Heppner County of Morrow

State of Oregon, do hereby make application for a certificate of registration as evidence of a right to appropriate ground water.

- 1. Source from which water is withdrawn is Pump Well # 2
(Flowing well, pump well, infiltration trench, or tunnel)
- 2. Location is: 12 Miles SE of Heppner Ore
(Approximate distance and direction from nearest city or town)

and is more particularly described as follows:

(a) ~~to SE 1/4 Sec 29~~ - 2030 ft North & 190 feet West of SE 1/4 Sec. 29
(Give distance and bearing to corner of section or other legal subdivision)

being within NE 1/4 SE 4 of Sec. 29, Twp. 35, Rge. 28 E
(Smallest legal subdivision) (T. or S.) (E. or W.)

or (b) within limits of recorded platted property, town or city:

in Lot _____ Block _____ of _____
(Name of plat or addition)

County of _____
(If within city or town, give name)

3. Construction Work was begun on 1932; was completed on 1932
(Date) (Date)

and the ground water claimed was first used for the purposes set out below on 1932
(Date)

since which time the water has been used intermittently
(Continuously or Intermittently)

from 1932 to 1953
(Date) (Date)

4. Quantity of water claimed and used is 550 gallons per minute; _____ acre feet per year.

5. Purpose or Purposes for which water is used Municipal

(Domestic, irrigation, municipal, manufacturing, industrial, etc.)

6. Description of Well: Depth 352 feet. Type Dug
(Dug or drilled)

diameter 10 inches. Elevation of ground at well site 2870 feet, mean sea level.
(As near as known)

Depth to water table 90 feet.

7. Capacity of Well: 3 g.p.m. with 1.7 feet drawdown.
350 g.p.m. with 114 feet drawdown.

Date of test _____

If Flowing Well: Measured discharge _____ g.p.m. on _____
(Date)

Shut-in pressure at ground surface _____ lbs. per sq. in. on _____
(Date)

Water is controlled by _____
(Cap, valve, etc.)

8. Casing: (Give diameter, commercial specifications and depth below ground surface of each casing size.)

10 inch diameter from 0 to 28 feet
 inch diameter from to feet
 inch diameter from to feet
 inch diameter from to feet

Describe and show depth of shoe, plug, adapter, liner or other details:

9. Perforated Casings or Screens:

(Number per foot and size of perforations, or describe screen) from to
 from to
 from to
 from to

10. Log of Well: (Describe each stratum or formation clearly, indicate if water bearing, and give thickness and depth as indicated.)

MATERIAL	Thickness (Feet)	Depth to Bottom (Feet)
Loose Rock & Boulders	1	20
SOFT ROCK to HARD ROCK	20	45
Crvice FORMATIONS	45	54
SOFT ROCK to VERY HARD ROCK	54	64
Water ROUGH HARD ROCK to MED HARD ROCK	64	88
HARD ROCK to MED HARD ROCK	88	134
MED HARD ROCK to VERY HARD CAP.	134	182
Water VERY HARD to MED to SOFT ROCK	182	209
Water SOFT ROCK to VERY HARD ROCK	209	224
VERY HARD ROCK to MED HARD ROCK	224	247
MED HARD ROCK to BLACK & RED ROCK	247	280
MED BLACK & RED ROCK to VERY HARD ROCK	280	325
VERY HARD BLACK ROCK & FLINT	325	352

If log of well is not available, give name and address of driller. P. J. STRASSER

Portland Oregon

11. Infiltration Trench: Covered or open

Dimensions: Length ft. Minimum depth ft. Maximum depth ft.

Bottom width ft. Discharge g.p.m. Date of test

12. Tunnel: Type of lining

Dimensions:
(Length, course, and cross sectional size)

Position of water bearing stratum with reference to portal of tunnel

Log of tunnel: (Preceding table for log of well may be used, if desired. Give footage from portal and character of materials, as pertinent.)

13. Pumping Equipment:

(a) Pump Peerless turbine 9 sq 8" HR 13 Capacity 500 g.p.m.
(Make, type and size)

(b) Motor AMP AND SMITH West HOLLOW SHAF. 3PHASE 60CY - 1800 RPM
(Type and horsepower)

14. Location of area irrigated or to be irrigated, or place of use if for purposes other than irrigation.

Township North or South	Range E. or W. of Willamette Meridian	Section	Forty-acre Tract	Number Acres To Be Irrigated	Date of Reclamation
<u>2 So.</u>	<u>26 E</u>	<u>26-27 34-35</u>		<u>Municipal uses</u>	<u>1932</u>
"	"	<u>26</u>	<u>SW⁴ all</u>	<u>160</u>	"
"	"	<u>27</u>	<u>SE⁴ all</u>	<u>160</u>	"
"	"	<u>34</u>	<u>NE⁴ all</u>	<u>160</u>	"
"	"	<u>"</u>	<u>N² SE⁴</u>	<u>80</u>	"
"	"	<u>35</u>	<u>NW⁴ all</u>	<u>160</u>	"
"	"	<u>"</u>	<u>N² SW⁴</u>	<u>80</u>	"


15. If the ground water supply is supplemental to an existing water supply, identification of any application for a permit, permit, certificate or adjudicated right to appropriate water made or held by the registrant.

Water Rights Held on Willow & Ditch Creek

on this same location as in Well #1

GR-4033

Township 35 Range 29 E W.M.
North

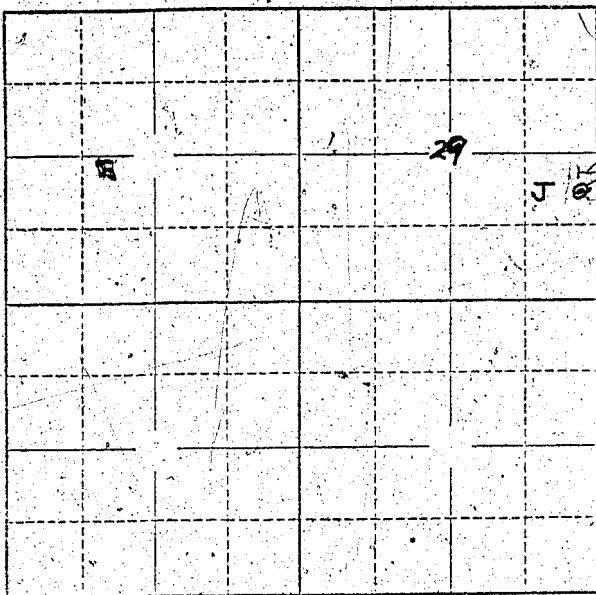

Locate well and acreage of irrigated land on plat.
Scale: 2" = 1 Mile

STATE OF OREGON

County of Morrow } ss.

I, Victor Groshens, being first duly sworn, do hereby certify that I have read the foregoing Registration Statement and that all of the items therein contained are true to the best of my knowledge and belief.

Victor Groshens
(Signature of Registrant)

Subscribed and sworn to before me this 20th day of July, 1958

My commission expires January 1, 1961

Delores Dava
(Notary Public)

(SEAL)

CERTIFICATE OF REGISTRATION

STATE OF OREGON

County of Marion } ss.

This is to certify that the foregoing Registration Statement was received in the office of the State Engineer on the 30th day of July, 1958, at 8:00 o'clock A. M. and has been duly recorded in said office in Book No. 16 of Registration Statements on page GR-4033.

~~Construction shall be completed by xxxxxxxxxxxxxxxxxx and the water completely applied to beneficial use by xxxxxxxxxxxxxxxxxx.~~

Witness my hand this 11th day of April, 1960

Laura A. Stephens
(State Engineer)

20.00

By _____ (Deputy)

GR-4033