

Registration Statement

RECEIVED
JUL 30 1958
STATE ENGINEER
SALES

OF CLAIMANT OF RIGHT TO APPROPRIATE GROUND WATER

TO THE STATE ENGINEER OF OREGON:

I, FRED DeFOREST
of R3 Box 303 Canby County of Clackamas
(Mailing address)

State of OREGON, do hereby make application for a certificate of registration as evidence of a right to appropriate ground water.

1. Source from which water is withdrawn is Pump Well
(Flowing well, pump well, infiltration trench, or tunnel)

2. Location is: 1 1/2 miles N. and W. of Canby
(Approximate distance and direction from nearest city or town)

and is more particularly described as follows:

(a) 500 feet west and 800 feet north from SE corner Section 29
SE 1/4 of SE 1/4 Tax lot No. C. Templeton DHC 58 of Sec. 29, Twp. 3 S, Rge. 1 E
(Give distance and bearing to corner of section or other legal subdivision)
(Smallest legal subdivision) (N. or S.) (E. or W.)

or (b) within limits of recorded platted property, town or city:

in Lot _____ Block _____ of _____
(Name of plat or addition)
County of Clackamas
(If within city or town, give name)

3. Construction Work was begun on Dec. 3, 1947; was completed on Dec. 5, 1947
(Date) (Date)

and the ground water claimed was first used for the purposes set out below on Mar. 4, 1954
(Date)

since which time the water has been used CONTINUOUSLY
(Continuously or Intermittently)

from MAR. 4, 1954 to JULY 29, 1958
(Date) (Date)

4. Quantity of water claimed and used is 24 gallons per minute; _____ acre feet per year.

5. Purpose or Purposes for which water is used exempt IRRIGATION
(Domestic, irrigation, municipal, manufacturing, industrial, etc.)

6. Description of Well: Depth 79 feet. Type DRILLED
(Dug or drilled)

diameter 6 inches. Elevation of ground at well site 75' feet, mean sea level.
(As near as known)

Depth to water table 60 feet.

7. Capacity of Well: 24 g.p.m. with 5 feet drawdown.

_____ g.p.m. with _____ feet drawdown.


Date of test Dec. 5, 1947

If Flowing Well: Measured discharge _____ g.p.m. on _____ (Date)

Shut-in pressure at ground surface _____ lbs. per sq. in. on _____ (Date)

Water is controlled by _____
(Cap. valve, etc.)

Township 35 Range 1E W.M.
North

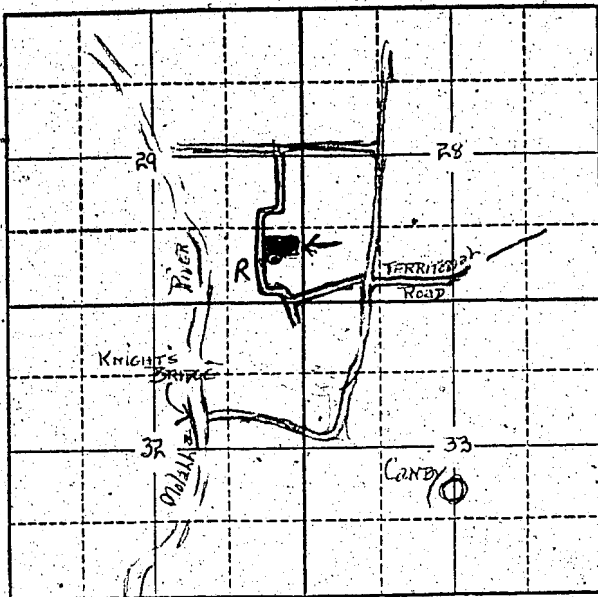

Locate well and acreage of irrigated land on plat.
Scale: 2" = 1 Mile

STATE OF OREGON }
County of Marion } ss.

I, _____, being first duly sworn, do hereby certify that I have read the foregoing Registration Statement and that all of the items therein contained are true to the best of my knowledge and belief.

Fred H. Frost
(Signature of Registrant)

Subscribed and sworn to before me this 29 day of July, 1958

My commission expires APRIL 3, 1962
Will E. Fisher
(Notary Public)

(SEAL)

CERTIFICATE OF REGISTRATION

STATE OF OREGON }
County of Marion } ss.

This is to certify that the foregoing Registration Statement was received in the office of the State Engineer on the 30 day of July, 1958, at 5:00 o'clock A. M. and has been duly recorded in said office in Book No. 12 of Registration Statements on page GR-2861

With my hand this 25th day of May, 1959

Lewis A. Stanley
(State Engineer)

By _____
(Deputy)

\$15.00

GR - 2861