

Registration Statement

RECEIVED
JUL 30 1958

OF CLAIMANT OF RIGHT TO APPROPRIATE GROUND WATER

STATE ENGINEER

TO THE STATE ENGINEER OF OREGON:

I, Clarence A. Nelsen

of 2580 S.W. 187th Ave., Aloha, Oregon County of Washington

(Mailing address)

State of Oregon, do hereby make application for a certificate of registration as evidence of a right to appropriate ground water.

1. Source from which water is withdrawn is Pump Well
(Flowing well, pump well, infiltration trench, or tunnel)

2. Location is: 1/2 Mile North of Aloha, Oregon
(Approximate distance and direction from nearest city or town)

and is more particularly described as follows:

(a) 25 1/2 Feet North of South Property Line & 103' East of West Property Line
(Give distance and bearing to corner of section or other legal subdivision)
being within One (1) Acre of Sec. 12 (Excluding 25' From Center of Road.)
(Smallest legal subdivision) (Twp. 1-6, Rge. 2-4, (S. or S.) (E. or W.)

or (b) within limits of recorded platted property, town or city: Aloha, Oregon
in Lot 74, Block _____ of Johnson Estate Addition
(Name of plat or addition)

Aloha, Oregon County of Washington
(If within city or town, give name)

3. Construction Work was begun on Prior to Aug. 1947; was completed on Prior to 1947
(Date) (Date)

and the ground water claimed was first used for the purposes set out below on August 1947
(Date)

since which time the water has been used Continuously for Domestic & Intermittently for Irrigation
(Continuously or Intermittently) (Date)

from August 1947 to Present Date
(Date) (Date)

4. Quantity of water claimed and used is 10 gallons per minute; 3/4 + acre
feet per year.

5. Purpose or Purposes for which water is used (exempt) Domestic & Irrigation of Garden, Lawn,
(exempt) Shrubs and Citrus.
(Domestic, irrigation, municipal, manufacturing, industrial, etc.)

6. Description of Well: Depth Approx. 30 feet. Type Dug Well
(Dug or drilled)
diameter 5 1/4 inches. Elevation of ground at well site 210 feet, mean sea level.
(As near as known)

Depth to water table 25 feet.

7. Capacity of Well: Unknown g.p.m. with Unknown feet drawdown.
Unknown g.p.m. with Unknown feet drawdown.

Date of test Unknown

If Flowing Well: Measured discharge _____ g.p.m. on _____
(Date)

Shut-in pressure at ground surface _____ lbs. per sq. in. on _____
(Date)

Water is controlled by _____
(Cap, valve, etc.)

8. Casing: (Give diameter, commercial specifications and depth below ground surface of each casing size.)

..... inch diameter *ink* from to feet
..... inch diameter from to feet
..... inch diameter from to feet
..... inch diameter from to feet

Describe and show depth of shoe, plug, adapter, liner or other details:

9. Perforated Casings or Screens:

..... from to
(Number per foot and size of perforations, or describe screen)
..... from to
..... from to
..... from to

10. Log of Well: (Describe each stratum or formation clearly, indicate if water bearing, and give thickness and depth as indicated.)

	MATERIAL	Thickness (Feet)	Depth to Bottom (Feet)
UNKNOWN		UNKNOWN	

If log of well is not available, give name and address of driller. UNKNOWN AND NO LOG AVAILABLE

11. Infiltration Trench: Covered or open

Dimensions: Length ft. Minimum depth ft. Maximum depth ft.

Bottom width ft. Discharge g.p.m. Date of test

12. Tunnel: Type of lining

Dimensions: (Length, course, and cross sectional size)

Position of water bearing stratum with reference to portal of tunnel

Log of tunnel: (Preceding table for log of well may be used, if desired. Give footage from portal and character of materials, as pertinent.)

13. Pumping Equipment:

(a) Pump JET (Jacuzzi) 5RR 1/2 H.P. Capacity 10 g.p.m. (Make, type and size)

(b) Motor Electric 1/2 H.P. (Type and horsepower)


14. Location of area irrigated or to be irrigated, or place of use if for purposes other than irrigation.

Table with 6 columns: Township North or South, Range E. or W. of Willamette Meridian, Section, Forty-acre Tract, Number Acres To Be Irrigated, Date of Reclamation. Includes handwritten entries: 1-S, 2-W, 12, S.E. 1/4 S.E. 1/4, 3/4, Aug. 1947.

15. If the ground water supply is supplemental to an existing water supply, identification of any application for a permit, permit, certificate or adjudicated right to appropriate water made or held by the registrant.

Purchase water from Aloha-Huber Water District for household use.

Township 1-South Range 2-West, W.M.
North

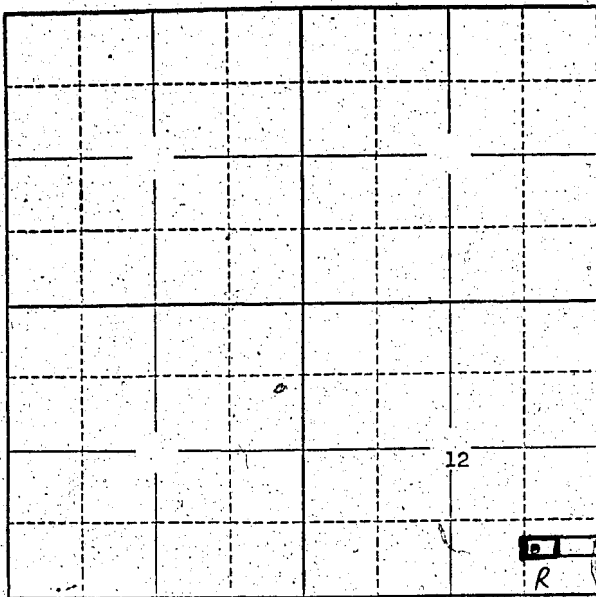

Locate well and acreage of irrigated land on plat.
Scale: 2" = 1 Mile

STATE OF OREGON

County of WASHINGTON ss.

I, CLARENCE A. NELSON being first duly sworn, do hereby certify that I have read the foregoing Registration Statement and that all of the items therein contained are true to the best of my knowledge and belief.

Clarence A. Nelson
(Signature of Registrant)

Subscribed and sworn to before me this 29th day of July, 1958

[Signature]
(Notary Public)

My commission expires 2-15-59

(SEAL)

CERTIFICATE OF REGISTRATION

STATE OF OREGON }
County of Marion } ss.

This is to certify that the foregoing Registration Statement was received in the office of the State Engineer on the 30th day of July, 1958, at 5:10 o'clock A.M. and has been duly recorded in said office in Book No. 12 of Registration Statements on page GR 2862

Witness my hand this 25th day of May, 1959

Lewis A. Stanley
(State Engineer)

By _____ (Deputy)

\$1500

GR - 2862