

Registration Statement

OF CLAIMANT OF RIGHT TO APPROPRIATE GROUND WATER

TO THE STATE ENGINEER OF OREGON:

I, Larry C. Tensen
of 234 N.W. 7th Ave County of Washington
(Mailing address)

State of Oregon do hereby make application for a certificate of registration as evidence of a right to appropriate ground water.

1. Source from which water is withdrawn is Pump Well
(Flowing well, pump well, infiltration trench, or tunnel)

2. Location is: Within City of Cornelius
(Approximate distance and direction from nearest city or town)

and is more particularly described as follows:

(a) 1000 feet north & 200 feet east from SW corner Section 33
(Give distance and bearing to corner of section or other legal subdivision)

being within Sublot SE 1/4 of Sec. 33, Twp. 1N, Rge. 3W
(Smallest legal subdivision) (N. or W.)

or (b) within limits of recorded platted property, town or city:

in Lot 26, Block _____ of Cornelius Farms
(Name of plat or addition)
Cornelius County of Washington
(If within city or town, give name)

3. Construction Work was begun on May 15, 1954; was completed on May 24, 1954
(Date) (Date)

and the ground water claimed was first used for the purposes set out below on June 2, 1954
(Date)

since which time the water has been used Intermittently (Summer months)
(Continuously or intermittently)

from June 2, 1954 to Present time
(Date) (Date)

4. Quantity of water claimed and used is 20 gallons per minute; 2 acre feet per year.
(% of 1 acre)

5. Purpose or Purposes for which water is used Irrigation
(Domestic, irrigation, municipal, manufacturing, industrial, etc.)

6. Description of Well: Depth 30 feet. Type Drilled
(Dug or drilled)

diameter 4 inches. Elevation of ground at well site 226 feet, mean sea level.
(As near as known)

Depth to water table 13 feet.

7. Capacity of Well: 65 g.p.m. with 5 feet drawdown.

100 g.p.m. with 13 feet drawdown.

Date of test June 6, 1954


If Flowing Well: Measured discharge _____ g.p.m. on _____
(Date)

Shut-in pressure at ground surface _____ lbs. per sq. in. on _____
(Date)

Water is controlled by _____
(Cap, valve, etc.)

Township 27 N Range 3 W W.M.

North

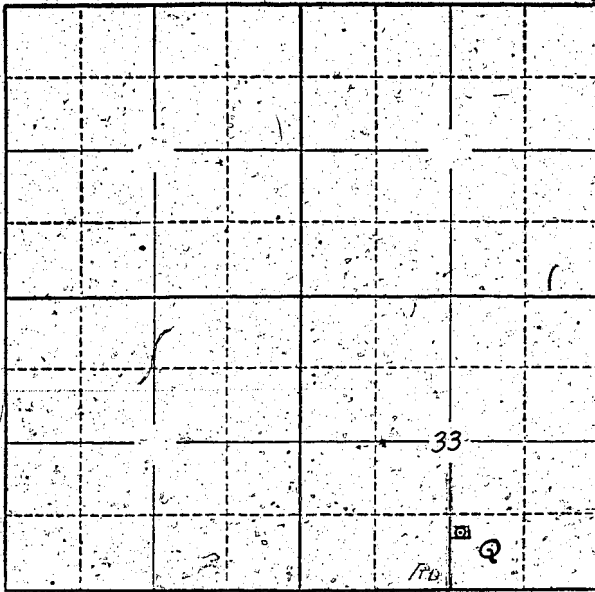

Locate well and acreage of irrigated land on plat.

Scale: 2" = 1 Mile

STATE OF OREGON

County of Washington } ss.

I, Harry O. Quinn being first duly sworn, do hereby certify that I have read the foregoing Registration Statement and that all of the items therein contained are true to the best of my knowledge and belief.

Harry O. Quinn
(Signature of Registrant)

Subscribed and sworn to before me this 29th day of July, 1958

My commission expires Oct. 4, 1958
Agnes P. Thompson
(Notary Public)

(SEAL)

CERTIFICATE OF REGISTRATION

STATE OF OREGON } ss.
County of Marion

This is to certify that the foregoing Registration Statement was received in the office of the State Engineer on the 30 day of July, 1958, at 5:00 o'clock A. M, and has been duly recorded in said office in Book No. 12 of Registration Statements on page GR-2863

Witness my hand this 25th day of May, 1959

Lewis A. Stanley
(State Engineer)

By _____
(Deputy)

\$15.00