

RECEIVED
OCT 1 1956
STATE ENGINEER

Well # 1

Registration Statement

REGISTRATION NO. GR-306

CERTIFICATE NO. GR-285

OF CLAIMANT OF RIGHT TO APPROPRIATE GROUND WATER

(Under Chapter 708, Oregon Laws 1955.)

TO THE STATE ENGINEER OF OREGON:

I, Dewitt Tiger

of Stayton County of Marion

State of Oregon, do hereby make application for a certificate of registration as evidence of a right to appropriate ground water.

1. Source from which water is withdrawn is pump well #1
(Flowing well, pump well, infiltration trench, or tunnel)

2. Location is: 1/2 mile south of Stayton, Oregon
(Approximate distance and direction from nearest city or town)

and is more particularly described as follows:

(a) South 56° 50' West 1028 feet from the east quarter corner of Sec. 15 T.9 S. 8' W.
(Give distance and bearing to corner of section or other legal subdivision)
being within NE 1/4 of SE of Sec. 15, Twp. 9 S, Rge. 1 W.
(Smallest legal subdivision) (N. or S.) (E. or W.)

or (b) within limits of recorded platted property, town or city:

in Lot _____, Block _____ of _____
(Name of plat or addition)

County of _____
(If within city or town, give name)

3. Construction Work was begun on April 1950; was completed on April 1950
(Date) (Date)

and the ground water claimed was first used for the purposes set out below on June 1, 1950
(Date)

since which time the water has been used continuously
(Continuously or intermittently)

from May 15 to October 1
(Date) (Date)

4. Quantity of water claimed and used is varies from 10 to 20 gallons per minute; 20 sprinklers to 10 a.
feet per year. possibly river water level affects

5. Purpose or Purposes for which water is used irrigation

(Domestic, irrigation, municipal, manufacturing, industrial, etc.)

6. Description of Well: Depth 22 feet. Type Drilled
(Dug or drilled)

diameter 6 inches. Elevation of ground at well site 430 feet, mean sea level.
(As near as known)

Depth to water table varies feet.

7. Capacity of Well: _____ g.p.m. with _____ feet drawdown.

_____ g.p.m. with _____ feet drawdown.

Date of test _____

If Flowing Well: Measured discharge _____ g.p.m. on _____
(Date)

Shut-in pressure at ground surface _____ lbs. per sq. in. on _____
(Date)

Water is controlled by _____
(Cap, valve, etc.)

..... inch diameter unknown from to feet

..... inch diameter from to feet

..... inch diameter from to feet

..... inch diameter from to feet

Unknown from to
(Number per foot and size of perforations, or describe screen) from to
from to
from to

[illegible]

GR-285A

11. Infiltration Trench: Covered or open _____

Bottom width ft. Discharge g.p.m. Date of test

12. Tunnel: Type of lining

Dimensions: _____
(Length, course, and cross sectional size)

Position of water bearing stratum with reference to portal of tunnel

Log of tunnel: (Preceding table for log of well may be used, if desired. Give footage from portal and character of materials, as pertinent.)

13. Pumping Equipment:

(a) Pump Horizontal centrifugal Fairbanks Morris Capacity 700 g.p.m.
(Make, type and size)

(b) Motor Electric Fairbank Morris 7 1/2 H. P. 3 phase
(Type and horsepower)


14. Location of area irrigated or to be irrigated, or place of use if for purposes other than irrigation.

[illegible]

15. If the ground water supply is supplemental to an existing water supply, identification of any application for a permit, permit, certificate or adjudicated right to appropriate water made or held by the registrant.

GR-285B

Township 9S Range 1W, W.M.
North

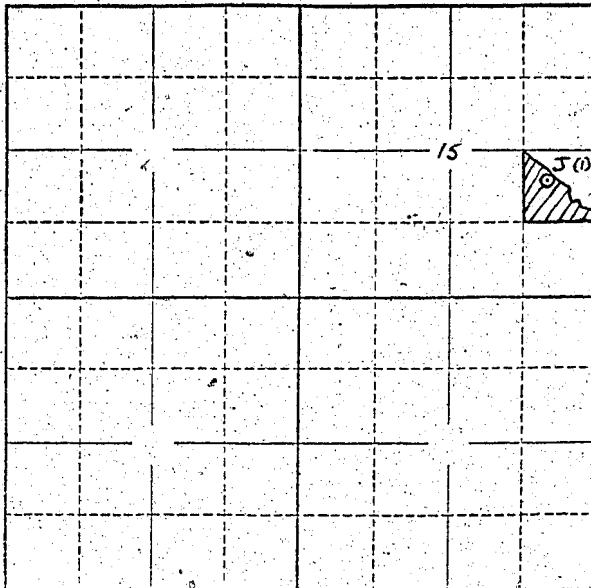

Locate well and acreage of irrigated land on plat.
Scale: 2" = 1 Mile

STATE OF OREGON

County of Marion } ss.

I, Sevett Tupper, being first duly sworn, do hereby certify that I have read the foregoing Registration Statement and that all of the items therein contained are true to the best of my knowledge and belief.

Sevett Tupper
(Signature of Registrant)

Subscribed and sworn to before me this 26 day of Sept, 1956.

My commission expires 3/21/59

Walter H. Bess
(Notary Public)

(SEAL)

SEE PAGE GR-285-G FOR
CERTIFICATE OF REGISTRATION

STATE OF OREGON

County of Marion } ss.


Witness my hand this _____ day of _____, 19____

(State Engineer)

By _____
(Deputy)

GR-285C

RECEIVED
OCT 1 1956
STATE ENGINEER
SALMON, OREGON

Well #2

Registration Statement

REGISTRATION NO. GR-306
CERTIFICATE NO. GR-285

OF CLAIMANT OF RIGHT TO APPROPRIATE GROUND WATER

(Under Chapter 708, Oregon Laws 1955.)

TO THE STATE ENGINEER OF OREGON:

I, Dewitt Tiger
of Stayton County of Marion

State of Oregon, do hereby make application for a certificate of registration as evidence of a right to appropriate ground water.

1. Source from which water is withdrawn is pump well No. 2
(Flowing well, pump well, infiltration trench, or tunnel)
2. Location is: $\frac{1}{2}$ mile south of Stayton, Oregon
(Approximate distance and direction from nearest city or town)

and is more particularly described as follows:

(a) South 25° 55' West 945 feet from the east quarter corner of Sec. 15 T. 9 S. R. 1 W. W. M.
(Give distance and bearing to corner of section or other legal subdivision)
being within NE $\frac{1}{4}$ of S $\frac{1}{2}$ of Sec. 15, Twp. 9 S., Rge. 1 W.
(Smallest legal subdivision) (N. or S.) (E. or W.)

or (b) within limits of recorded platted property, town or city:
in Lot _____, Block _____ of _____
(Name of plat or addition)

County of _____
(If within city or town, give name)

3. Construction Work was begun on Dec. 1954; was completed on Dec. 1954
(Date) (Date)

and the ground water claimed was first used for the purposes set out below on May 1955
(Date)

since which time the water has been used continuously during irrigation season
(Continuously or intermittently)

from May to September 1
(Date) (Date)

4. Quantity of water claimed and used is 100 claimed 150 gal. per min - 15 gallons per minute; 10 acre feet per year

5. Purpose or Purposes for which water is used irrigation

(Domestic, irrigation, municipal, manufacturing, industrial, etc.)

6. Description of Well: Depth 15' feet. Type dug
(Dug or drilled)
diameter 4' inches. Elevation of ground at well site 430 feet, mean sea level.
(As near as known)
Depth to water table 10' feet.

7. Capacity of Well: 100 g.p.m. with None feet drawdown.
? g.p.m. with ? feet drawdown.

Date of test one day during irrigation.

If Flowing Well: Measured discharge _____ g.p.m. on _____
(Date)

Shut-in pressure at ground surface _____ lbs. per sq. in. on _____
(Date)

Water is controlled by _____
(Cap, valve, etc.)

GR-285D

open no brick or rockd

..... inch diameter from to feet

..... inch diameter from to feet

..... inch diameter from to feet

Describe and show depth of shoe, plug, adapter, liner or other details:

(Number per foot and size of perforations, or describe screen)

from to

from to

from to

from to

[illegible]

GR-285E

11. **Infiltration Trench:** Covered or open

Bottom width ft. Discharge g.p.m. Date of test

Dimensions: _____
(Length, course, and cross sectional size)

Position of water bearing stratum with reference to portal of tunnel

13. Pumping Equipment:


(a) Pump Westinghouse Centrifugal Capacity 105 g.p.m.
(Make, type and size)

(b) Motor Westinghouse, single phase 4 H. P.
(Type and horsepower)

Township North or South	Range E. or W. of Willamette Meridian	Section	Forty-acre Tract	Number Acres To Be Irrigated	Date of Reclamation
The land on which the wells are located and on which this water is used for irrigati purpose, is located in the NE$\frac{1}{4}$ of SE$\frac{1}{4}$ of SW 15 T. 9 S. R. 1 W. W. M., Linn County, O gon and more particularly described as follows, The Northeast quarter of the southeast quarter of Section 15, T. 9 S. R. 1 W. W. M. Linn County, Oregon; Subject to the right of the public in roads. Except: Beginn at the east one quarter corner of said Section 15; thence south on the section line feet; thence west 261.98 feet; thence north 92.89 feet; thence N. 76° W. 140.0 feet thence North 280.0 feet to the center line of the county road; thence north 76° west on the center line of the said county road 182.0 feet; thence continuing on the cent line of the said county road to its intersection with the west boundary of the N. E. of S. E. $\frac{1}{4}$ of said Section 15, thence north on said west boundary 99.0 feet to the N corner of said described 40 acre subdivision; thence east on the north boundary to t place of beginning.					
9S	1W	15	NE $\frac{1}{4}$ of SE $\frac{1}{4}$	27.5	1955

GR-285F

Township 9S Range 14W, W.M.
North

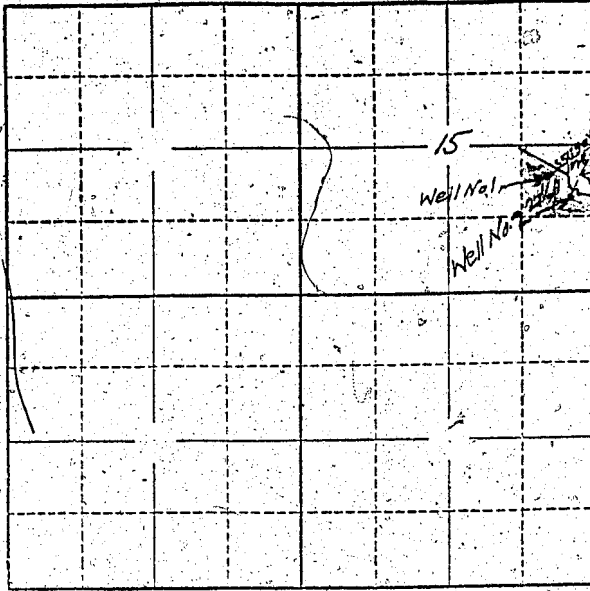

Locate well and acreage of irrigated land on plat.

Scale: 2" = 1 Mile

STATE OF OREGON

County of Marion

ss.

I, Walter H. Begg, being first duly sworn, do hereby certify that I have read the foregoing Registration Statement and that all of the items therein contained are true to the best of my knowledge and belief.

(Signature of Registrant)

Subscribed and sworn to before me this 7th day of Sept, 1956.

My commission expires 8/21/58

(Notary Public)

(SEAL)

CERTIFICATE OF REGISTRATION

STATE OF OREGON

County of Marion

ss.

This is to certify that the foregoing Registration Statement was received in the office of the State Engineer on the 1st day of October, 1956, at 8 o'clock A.M. and has been duly recorded in said office in Book No. 2 of Registration Statements on page GR-285-G.

~~Construction shall be completed by 1958 and the water completed by 1958.~~

Witness my hand this 15th day of January, 1957.

(State Engineer)

By

(Deputy)

GR-285-G