

RECEIVED
JUL 26 1958
STATE ENGINEER

Registration No. GR. - 3060

Certificate No. GR. 3819

Registration Statement

OF CLAIMANT OF RIGHT TO APPROPRIATE GROUND WATER

TO THE STATE ENGINEER OF OREGON:

I, James P. Lathrop
of Williams County of Josephine
State of Oregon, do hereby make application for a certificate of registration as evidence of a right to appropriate ground water.

1. Source from which water is withdrawn is infiltration hole or trench
(Flowing well, pump well, infiltration trench, or tunnel)

2. Location is: three miles S.W. of Williams
(Approximate distance and direction from nearest city or town)

and is more particularly described as follows:

(a) 300' W and 800' S of N.W. cor. of Sec. 8
(Give distance and bearing to corner of section or other legal subdivision)

being within N.E. 1/4 N.W. 1/4 of Sec. 8, Twp. 39 S, Rge. 5 W
(Smallest legal subdivision) (N. or S.) (E. or W.)

or (b) within limits of recorded platted property, town or city:

in Lot _____, Block _____ of _____
(Name of plat or addition)

County of _____
(If within city or town, give name)

3. Construction Work was begun on July - 1950; was completed on Oct. 13, 1950
(Date) (Date)

and the ground water claimed was first used for the purposes set out below on Oct. 13, 1950
(Date)

since which time the water has been used intermittently
(Continuously or intermittently)

from 1950 to 1958
(Date) (Date)

4. Quantity of water claimed and used is 0.59 cubic feet per second gallons per minute; _____ acre feet per year.

5. Purpose or Purposes for which water is used irrigation

(Domestic, irrigation, municipal, manufacturing, industrial, etc.)

6. Description of Well: Depth 10 feet. Type aug - drier - dragline
(Dug or drilled)
diameter 40 feet inches. Elevation of ground at well site 1400 feet, mean sea level.
(As near as known)

Depth to water table 4 feet.

7. Capacity of Well: never been pumped dry g.p.m. with _____ feet drawdown.

_____ g.p.m. with _____ feet drawdown.

Date of test _____


If Flowing Well: Measured discharge _____ g.p.m. on _____
(Date)

Shut-in pressure at ground surface _____ lbs. per sq. in. on _____
(Date)

Water is controlled by _____
(Cap, valve, etc.)

Township 39 S Range 5 W, W.M.

North

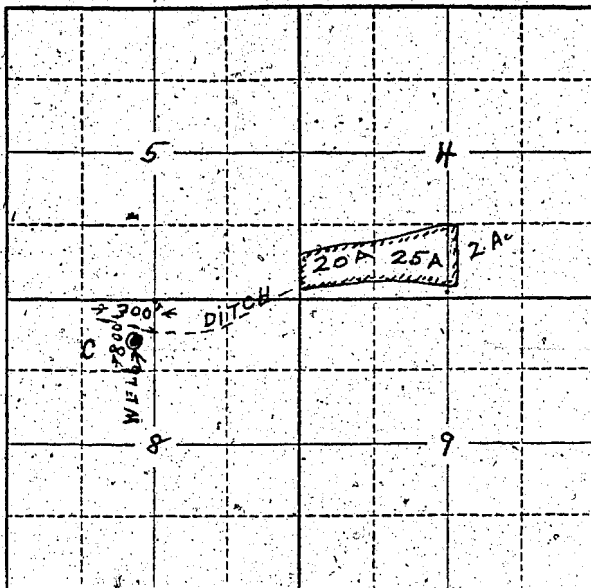

Locate well and acreage of irrigated land on plat.

Scale: 2" = 1 Mile

STATE OF OREGON

County of Washington

ss.

I, James S. Lathrop, being first duly sworn, do hereby certify that I have read the foregoing Registration Statement and that all of the items therein contained are true to the best of my knowledge and belief.

James S. Lathrop
(Signature of Registrant)

Subscribed and sworn to before me this 19 day of July, 1958.

My commission expires May 19, 1960

[Signature]
(Notary Public)

(SEAL)

CERTIFICATE OF REGISTRATION

STATE OF OREGON

County of Marion

ss.

This is to certify that the foregoing Registration Statement was received in the office of the State Engineer on the 30 day of July, 1958, at 8:00 o'clock A. M. and has been duly recorded in said office in Book No. 16 of Registration Statements on page 68-3819

Witness my hand this 4th day of December, 1959

Lewis A. Stanley
(State Engineer)

By _____ (Deputy)

GR 3819

\$12.55