

RECEIVED
JUL 3 1956
STATE ENGINEER

Registration No. GR - 3061

Certificate No. GR - 2865

Registration Statement

OF CLAIMANT OF RIGHT TO APPROPRIATE GROUND WATER

TO THE STATE ENGINEER OF OREGON:

I, Mrs. Carolyn H. Kelsey
of Cottage Kitchen, Trail, County of Jackson
(Mailing address)
State of Oregon, do hereby make application for a certificate of registration as evidence of a right to appropriate ground water.

1. Source from which water is withdrawn is Pump Well
(Flowing well, pump well, infiltration trench, or tunnel)
2. Location is: 5 miles East of Trail post office on Highway #62
(Approximate distance and direction from nearest city or town)

and is more particularly described as follows:

(a) 520 feet North and 215 feet West from the center of Section 32
(Give distance and bearing to corner of section or other legal subdivision)
being within SE $\frac{1}{4}$ NW $\frac{1}{4}$ of Sec. 32, Twp. 35 S., Rge. 1 E.
(Smallest legal subdivision) (N. or S.) (E. or W.)

or (b) within limits of recorded platted property, town or city:
in Lot _____, Block _____ of _____
(Name of plat or addition)
County of _____
(If within city or town, give name)

3. Construction Work was begun on February 1949; was completed on February 1949
(Date) (Date)
and the ground water claimed was first used for the purposes set out below on May 1949
(Date)
since which time the water has been used continuously
(Continuously or intermittently)

from May 1949 to present
(Date) (Date)

4. Quantity of water claimed and used is 30 gallons per minute; _____ acre
feet per year. > 15 g.p.d. supplemental

5. Purpose or Purposes for which water is used Use in Cafe and irrigation
(Domestic, irrigation, municipal, manufacturing, industrial, etc.)

6. Description of Well: Depth 110 feet. Type Drilled
(Dug or drilled)
diameter 6.0 inches. Elevation of ground at well site 1400 feet, mean sea level.
(As near as known)
Depth to water table not known feet.

7. Capacity of Well: _____ g.p.m. with _____ feet drawdown.
_____ g.p.m. with _____ feet drawdown.

Date of test February 1949

If Flowing Well: Measured discharge _____ g.p.m. on _____
(Date)

Shut-in pressure at ground surface _____ lbs. per sq. in. on _____
(Date)

Water is controlled by _____
(Cap, valve, etc.)

If log of well is not available, give name and address of driller. Diester's Well Drilling Co.,

139 Vancouver Avenue, Medford, Oregon.

11. Infiltration Trench: Covered or open

Dimensions: Length ft. Minimum depth ft. Maximum depth ft.

Bottom width ft. Discharge g.p.m. Date of test

12. Tunnel: Type of lining

Dimensions: (Length, course, and cross sectional size)

Position of water bearing stratum with reference to portal of tunnel

Log of tunnel: (Preceding table for log of well may be used, if desired. Give footage from portal and character of materials, as pertinent.)

13. Pumping Equipment:

(a) Pump Have pump, but don't know make, type, or size. Capacity 35 1/3 g.p.m.

(b) Motor Electric 2 HP (Type and horsepower)

14. Location of area irrigated or to be irrigated, or place of use if for purposes other than irrigation.


Table with 6 columns: Township North or South, Range E. or W. of Willamette Meridian, Section, Forty-acre Tract, Number Acres To Be Irrigated, Date of Reclamation. Row 1: 33 S., 1 E., 32, SE 1/4 NW 1/4, 2.3 acres, May 1949. Row 2: and use in cafe.

15. If the ground water supply is supplemental to an existing water supply, identification of any application for a permit, permit, certificate or adjudicated right to appropriate water made or held by the registrant.

Supplemental in part to a right in the Rogue River Decree, Page 3, Col. 1, initiated in the name of N. Hazel Enyart, Trail, Oregon, (Proof 11, Vol. 1) Priority 1880.

Township 33 S Range 1 E W.M.

North

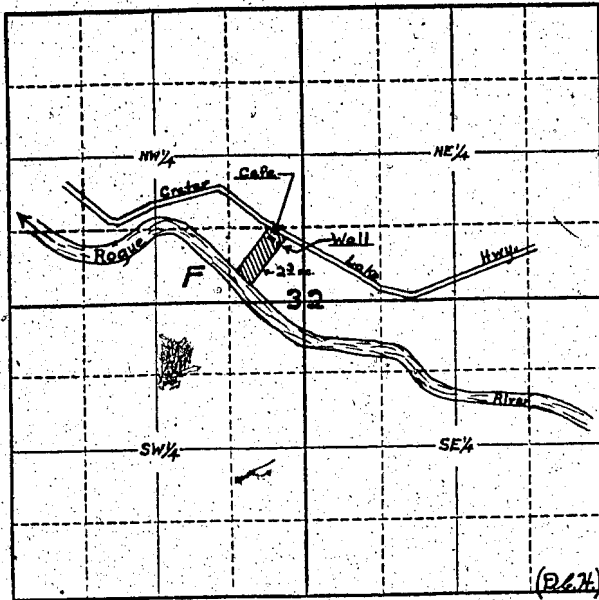

Locate well and acreage of irrigated land on plat.

Scale: 4" = 1 Mile

STATE OF OREGON

County of Jackson

ss.

I, Mrs. Carolyn H. Kelsey, being first duly sworn, do hereby certify that I have read the foregoing Registration Statement and that all of the items therein contained are true to the best of my knowledge and belief.

X Carolyn H. Kelsey (Signature of Registrant)

Subscribed and sworn to before me this 28th day of July, 1958

My commission expires August 25, 1958

(Notary Public)

(SEAL)

CERTIFICATE OF REGISTRATION

STATE OF OREGON

County of Marion

ss.

This is to certify that the foregoing Registration Statement was received in the office of the State Engineer on the 30th day of July, 1958, at 9:00 o'clock A.M. and has been duly recorded in said office in Book No. 12 of Registration Statements on page GR 2865

Witness my hand this 25th day of May, 1959

Laura A. Stanley (State Engineer)

By (Deputy)

25.00

GR - 2865