

RECEIVED  
JUL 30 1953  
STATE ENGINEER

# Registration Statement

## OF CLAIMANT OF RIGHT TO APPROPRIATE GROUND WATER

TO THE STATE ENGINEER OF OREGON:

ASSIGNED, See Misc. Rec., Vol. 4 Page 83

I, J. A. FAZZLE  
of RT. 1 MADRAS, ORE County of JEFFERSON  
(Mailing address)

State of OREGON, do hereby make application for a certificate of registration as evidence of a right to appropriate ground water.

1. Source from which water is withdrawn is FLOWING WELL  
(Flowing well, pump well, infiltration trench, or tunnel)

2. Location is: 6 MILES NORTHWEST OF FOREST GROVE  
(Approximate distance and direction from nearest city or town)

and is more particularly described as follows:

(a) ABOUT 13.25 CHAINS EAST OF NORTHWEST CORNER OF SE 1/4 TRACT 200 FT. S. 7  
(Give distance and bearing to corner of section or other legal subdivision)

being within NW 1/4 OF THE NW 1/4 of Sec. 11, Twp. 1 N, Rge. 4 W  
(Smallest legal subdivision) (N. or S.) (E. or W.)

or (b) within limits of recorded platted property, town or city:

in Lot \_\_\_\_\_, Block \_\_\_\_\_ of \_\_\_\_\_  
(Name of plat or addition)

County of WASHINGTON  
(If within city or town, give name)

3. Construction Work was begun on ABOUT 1950; was completed on 25 APRIL 1952  
(Date) (Date)

and the ground water claimed was first used for the purposes set out below on 1950  
(Date)

since which time the water has been used CONTINUOUSLY  
(Continuously or intermittently)

from 1950 to JULY 28, 1958  
(Date) (Date)

4. Quantity of water claimed and used is 66 gallons per minute; 3.5 acre feet per year.

5. Purpose or Purposes for which water is used IRRIGATION  
PURPOSES  
(Domestic, irrigation, municipal, manufacturing, industrial, etc.)

6. Description of Well: Depth 428 feet. Type DRILLED  
(Dug or drilled)

diameter 6 inches. Elevation of ground at well site ABOUT 100 feet, mean sea level.  
(As near as known)

Depth to water table ARTESIAN feet.

7. Capacity of Well: 400 g.p.m. with 0 feet drawdown.

66 g.p.m. with 50 feet drawdown.

Date of test APRIL 1952

If Flowing Well: Measured discharge 7 g.p.m. on APRIL 1952  
(Date)

Shut-in pressure at ground surface ABOUT 3 lbs. per sq. in. on 1955  
(Date)

Water is controlled by NONE  
(Cap, valve, etc.)

8. Casing: (Give diameter, commercial specifications and depth below ground surface of each casing size.)

6 inch diameter ..... not known ..... from 0 to 54'7" feet  
 6 x 5/8 inch diameter ..... not known ..... from 54'7" to 390'6" feet  
 ..... inch diameter ..... from 390'6" to ..... feet  
 ..... inch diameter ..... from ..... to ..... feet

Describe and show depth of shoe, plug, adapter, liner or other details: NONE

9. Perforated Casings or Screens:

NONE ..... from ..... to .....  
 (Number per foot and size of perforations, or describe screen)  
 ..... from ..... to .....  
 ..... from ..... to .....  
 ..... from ..... to .....

10. Log of Well: (Describe each stratum or formation clearly, indicate if water bearing, and give thickness and depth as indicated.)

MATERIAL	Thickness (Feet)	Depth to Bottom (Feet)
FIRST 309 FEET WAS DUG BEFORE I OBTAINED PROPERTY, I HAVE NO WAY OF GETTING LOG ON THAT	309	
RED SHOT CLAY	27	336
LAVA ROCK	17	413
HARD ROCK	15	428

If log of well is not available, give name and address of driller. A.M. JANNSEN DRILLING CO., P.O. Box 76, REEDVILLE, OREGON

11. Infiltration Trench: Covered or open

Dimensions: Length          ft. Minimum depth          ft. Maximum depth          ft.

Bottom width          ft. Discharge          g.p.m. Date of test         

12. Tunnel: Type of lining         

Dimensions:           
(Length, course, and cross sectional size)

Position of water bearing stratum with reference to portal of tunnel         

Log of tunnel: (Preceding table for log of well may be used, if desired. Give footage from portal and character of materials, as pertinent.)

13. Pumping Equipment:

(a) Pump FAIRBANKS MORSE - JET Capacity + 66 g.p.m.  
(Make, type and size)


(b) Motor ELECTRIC - 5HP  
(Type and horsepower)

14. Location of area irrigated or to be irrigated, or place of use if for purposes other than irrigation.

Township North or South	Range E or W of Willamette Meridian	Section	Forty-acre Tract	Number Acres To Be Irrigated	Date of Reclamation
1 N	4 W	11	NW 1/4 of NW 1/4	20.0	BEFORE 1950

15. If the ground water supply is supplemental to an existing water supply, identification of any application for a permit, permit, certificate or adjudicated right to appropriate water made or held by the registrant.

Township 1 N Range 4 W, W.M.  
North COVAD ROAD  
well

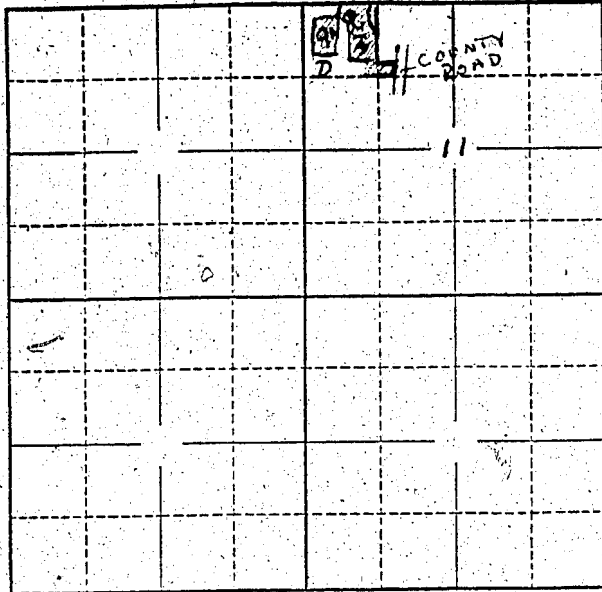

Locate well and acreage of irrigated land on plat.  
Scale: 2" = 1 Mile

STATE OF OREGON

County of T Jefferson } ss.

I, J. A. Fazole, being first duly sworn, do hereby certify that I have read the foregoing Registration Statement and that all of the items therein contained are true to the best of my knowledge and belief.

J. A. Fazole  
(Signature of Registrant)

Subscribed and sworn to before me this 22<sup>nd</sup> day of July, 1958.

My commission expires May 9, 1962

[Signature]  
(Notary Public)

(SEAL)

**CERTIFICATE OF REGISTRATION**

STATE OF OREGON } ss.  
County of Marion

This is to certify that the foregoing Registration Statement was received in the office of the State Engineer on the 30<sup>th</sup> day of July, 1958, at 5:00 o'clock A. M. and has been duly recorded in said office in Book No. 12 of Registration Statements on page OR-2867

Witness my hand this 25<sup>th</sup> day of May, 1959.

Lewis A. Stanley  
(State Engineer)

By \_\_\_\_\_  
(Deputy)

#1500