

Registration Statement

OF CLAIMANT OF RIGHT TO APPROPRIATE GROUND WATER

TO THE STATE ENGINEER OF OREGON:

I, The Keizer Water District
of 3425 River Road N.E., Salem County of Marion
(Mailing address)

State of Oregon, do hereby make application for a certificate of registration as evidence of a right to appropriate ground water.

1. Source from which water is withdrawn is Pump Well (Shoreline Well) #1
(Flowing well, pump well, infiltration trench, or tunnel)

2. Location is: In the Keizer District north of the City of Salem
(Approximate distance and direction from nearest city or town)

and is more particularly described as follows:

(a) See (b)
(Give distance and bearing to corner of section or other legal subdivision)

being within _____ of Sec. _____, Twp. _____, Rge. _____
(Smallest legal subdivision) (N. or S.) (E. or W.)

or (b) within limits of recorded platted property, town or city:

in Lot 7, Block 14 of Manhrin Gardens Annex No. 2
(Name of plat or addition)

County of Marion
(If within city or town, give name)

3. Construction Work was begun on 1943; was completed on 1943
(Date) (Date)

and the ground water claimed was first used for the purposes set out below, on 1943
(Date)

since which time the water has been used continuously
(Continuously or intermittently)

from 1943 to Oct 1957
(Date) (Date)

4. Quantity of water claimed and used is 700 gallons per minute; _____ acre feet per year.

5. Purpose or Purposes for which water is used _____

Municipal water district
(Domestic, irrigation, municipal, manufacturing, industrial, etc.)

6. Description of Well: Depth 140 feet. Type drilled
(Dug or drilled)

diameter 12 inches. Elevation of ground at well site 132 feet, mean sea level.
(As near as known)

Depth to water table 25 feet.

7. Capacity of Well: 700 g.p.m. with 98 feet drawdown.

_____ g.p.m. with _____ feet drawdown.

Date of test May 5, 1953

If Flowing Well: Measured discharge _____ g.p.m. on _____
(Date)

Shut-in pressure at ground surface _____ lbs. per sq. in. on _____
(Date)

Water is controlled by _____
(Cap, valve, etc.)

If log of well is not available, give name and address of driller.....

11. Infiltration Trench: Covered or open

Dimensions: Length ft. Minimum depth ft. Maximum depth ft.

Bottom width ft. Discharge g.p.m. Date of test

12. Tunnel: Type of lining

Dimensions:
(Length, course, and cross sectional size)

Position of water bearing stratum with reference to portal of tunnel

Log of tunnel: (Preceding table for log of well may be used, if desired. Give footage from portal and character of materials, as pertinent.)

13. Pumping Equipment:

(a) Pump Berkley *Turbine* Capacity g.p.m.
(Make, type and size)

(b) Motor 25 hp *Electric*
(Type and horsepower)


14. Location of area irrigated or to be irrigated, or place of use if for purposes other than irrigation.

Township North or South	Range E. or W. of Willamette Meridian	Section	Forty-acre Tract	Number Acres To Be Irrigated	Date of Reclamation
T6S	R3W	34	NE 1/4 SE 1/4 NW 1/4 SE 1/4 SE 1/4 SW 1/4 SW 1/4 SE 1/4	<i>Municipal</i>	<i>1943</i>
T6S	R3W	35	SE 1/4 SE 1/4 NW 1/4 SW 1/4 NE 1/4 SW 1/4 SW 1/4 SW 1/4 SE 1/4 SW 1/4 SW 1/4 SE 1/4		
T7S	R5W	1	NW 1/4 NW 1/4 SW 1/4 NW 1/4 NW 1/4 SW 1/4 SW 1/4 SW 1/4		
T7S	R3W	2	ALL		
T7S	R3W	3	NE 1/4 NW 1/4 NW 1/4 NE 1/4 NE 1/4 NE 1/4 SE 1/4 NE 1/4 NE 1/4 SE 1/4 SE 1/4 SE 1/4		
T7S	R3W	10	NE 1/4 NE 1/4 NE 1/4 NE 1/4 SW 1/4 NE 1/4 SE 1/4 NE 1/4 NW 1/4 SE 1/4 NE 1/4 SE 1/4 SW 1/4 SE 1/4 NE 1/4 SE 1/4		
T7S	R3W	12	ALL NW 1/4 NW 1/4		
T7S	R3W	16	SE 1/4 NW 1/4 NW 1/4 NW 1/4 SE 1/4 NW 1/4 NW 1/4 NE 1/4 NE 1/4 NE 1/4		
T7S	R3W	15	NE 1/4 NE 1/4 NE 1/4 NE 1/4		

Also area to be annexed in the future.

15. If the ground-water supply is supplemental to an existing water supply, identification of any application for a permit, permit, certificate or adjudicated right to appropriate water made or held by the registrant.

Township 7.5 Range 3W W.M.
North

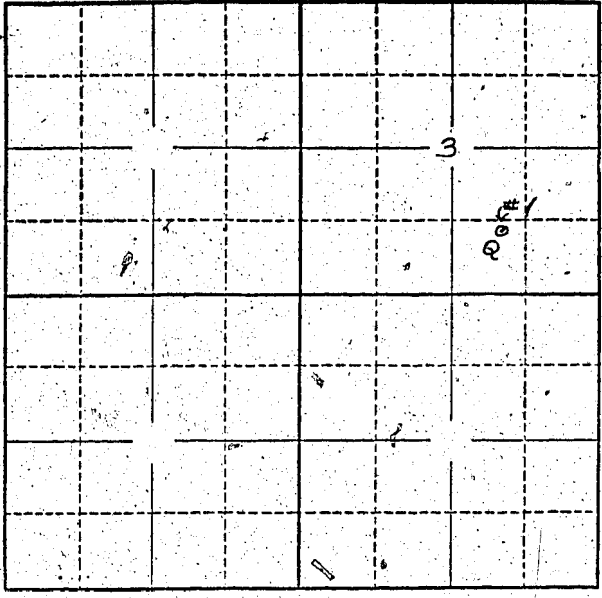

Locate well and acreage of irrigated land on plat.
Scale: 2" -- 1 Mile

STATE OF OREGON

County of Marion } ss.

I, D. Slater, being first duly sworn, do hereby certify that I have read the foregoing Registration Statement and that all of the items therein contained are true to the best of my knowledge and belief.

Notary Public District

D. Slater
(Signature of Registrant)

Subscribed and sworn to before me this 29th day of July, 1958

My commission expires Oct. 3, 1959

V. P. Halls
(Notary Public)

(SEAL)

CERTIFICATE OF REGISTRATION

STATE OF OREGON

County of Marion } ss.

This is to certify that the foregoing Registration Statement was received in the office of the State Engineer on the 30th day of July, 1958, at 8:30 o'clock A.M. and has been duly recorded in said office in Book No. 12 of Registration Statements on page GR 2868

Witness my hand this 25th day of May, 1959

Lucretia A. Stanley
(State Engineer)

By _____ (Deputy)

\$22.00

GR-2868