

# Registration Statement

## OF CLAIMANT OF RIGHT TO APPROPRIATE GROUND WATER

### TO THE STATE ENGINEER OF OREGON:

I, The Keizer Water District  
of 3425 River Road N.E., Salem County of Marion  
(Mailing address)

State of Oregon, do hereby make application for a certificate of registration as evidence of a right to appropriate ground water.

1. Source from which water is withdrawn is Pump Well Toni Well #50  
(Flowing well, pump well, infiltration trench, or tunnel)

2. Location is: In the Keizer District north of the City of Salem  
(Approximate distance and direction from nearest city or town)

and is more particularly described as follows:

(a) See (b)  
(Give distance and bearing to corner of section or other legal subdivision)

being within SW 1/4 of SW 1/4 of Sec. 2, Twp. 7S Rge. 3W  
(Smallest legal subdivision) (N. or S.) (E. or W.)

or (b) within limits of recorded platted property, town or city:

in Lot 6, Block 2 of Manbrin Gardens  
(Name of plat or addition)

County of Marion  
(If within city or town, give name)

3. Construction Work was begun on 1943; was completed on 1943  
(Date) (Date)

and the ground water claimed was first used for the purposes set out below on 1943  
(Date)

since which time the water has been used continuously  
(Continuously or intermittently)

from 1943 to Oct. 1957  
(Date) (Date)

4. Quantity of water claimed and used is 450 gallons per minute; \_\_\_\_\_ acre feet per year.

5. Purpose or Purposes for which water is used \_\_\_\_\_  
Municipal water district  
(Domestic, irrigation, municipal, manufacturing, industrial, etc.)

6. Description of Well: Depth 135 feet. Type drilled  
(Dug or drilled)

diameter 12 inches. Elevation of ground at well site 132 feet, mean sea level.  
(As near as known)

Depth to water table 20 feet.

7. Capacity of Well: 140 g.p.m. with 99 feet drawdown.  
\_\_\_\_\_ g.p.m. with \_\_\_\_\_ feet drawdown.

Date of test Jan. 23, 1947

If Flowing Well: Measured discharge \_\_\_\_\_ g.p.m. on \_\_\_\_\_  
(Date)

Shut-in pressure at ground surface \_\_\_\_\_ lbs. per sq. in. on \_\_\_\_\_  
(Date)

Water is controlled by \_\_\_\_\_  
(Cap, valve, etc.)

8. Casing: (Give diameter, commercial specifications and depth below ground surface of each casing size.)

12 inch diameter steel casing from 0 to 135 feet  
 \_\_\_\_\_ inch diameter \_\_\_\_\_ from \_\_\_\_\_ to \_\_\_\_\_ feet  
 \_\_\_\_\_ inch diameter \_\_\_\_\_ from \_\_\_\_\_ to \_\_\_\_\_ feet  
 \_\_\_\_\_ inch diameter \_\_\_\_\_ from \_\_\_\_\_ to \_\_\_\_\_ feet

Describe and show depth of shoe, plug, adapter, liner or other details: \_\_\_\_\_

9. Perforated Casings or Screens:

unknown from \_\_\_\_\_ to \_\_\_\_\_  
 (Number per foot and size of perforations, or describe screen)  
 \_\_\_\_\_ from \_\_\_\_\_ to \_\_\_\_\_  
 \_\_\_\_\_ from \_\_\_\_\_ to \_\_\_\_\_  
 \_\_\_\_\_ from \_\_\_\_\_ to \_\_\_\_\_

10. Log of Well: (Describe each stratum or formation clearly, indicate if water bearing, and give thickness and depth as indicated.)

MATERIAL	Thickness (Feet)	Depth to Bottom (Feet)
<u>sand &amp; gravel</u>	<u>5</u>	

If log of well is not available, give name and address of driller. .... A. M. Jensen .....

11. Infiltration Trench: Covered or open .....

Dimensions: Length ..... ft. Minimum depth ..... ft. Maximum depth ..... ft.

Bottom width ..... ft. Discharge ..... g.p.m. Date of test .....

12. Tunnel: Type of lining .....

Dimensions: .....  
(Length, course, and cross sectional size)

Position of water bearing stratum with reference to portal of tunnel .....

Log of tunnel: (Preceding table for log of well may be used, if desired. Give footage from portal and character of materials, as pertinent.)

13. Pumping Equipment:

(a) Pump ..... Lane bowler *Turbine* ..... Capacity ..... g.p.m.  
(Make, type and size)

(b) Motor ..... 25 hp *Electric* .....  
(Type and horsepower)


14. Location of area irrigated or to be irrigated, or place of use if for purposes other than irrigation.

Township North or South	Range E. or W. of Willamette Meridian	Section	Forty-acre Tract	Number Acres To Be Irrigated	Date of Reclamation
T6S	R3W	34	NE 1/4 SE 1/4 NW 1/4 SE 1/4 SE 1/4 SW 1/4 SW 1/4 SE 1/4	<i>Municipal</i>	<i>1943</i>
T6S	R3W	35	SE 1/4 SE 1/4 NW 1/4 SW 1/4 NE 1/4 SW 1/4 SW 1/4 SW 1/4 SE 1/4 SW 1/4 SW 1/4 SE 1/4		
T7S	R3W	1	NW 1/4 NW 1/4 SE 1/4 NW 1/4 NW 1/4 SW 1/4 SW 1/4 SW 1/4		
T7S	R3W	2	ALL	<i>e</i>	
T7S	R3W	3	NE 1/4 NW 1/4 NW 1/4 NE 1/4 NE 1/4 NE 1/4 SW 1/4 NE 1/4 SE 1/4 NE 1/4 NW 1/4 SE 1/4 NE 1/4 SE 1/4 SW 1/4 SE 1/4 SE 1/4 SE 1/4		
T7S	R3W	10	NW 1/4 NE 1/4 NE 1/4 NE 1/4 SW 1/4 NE 1/4 SE 1/4 NE 1/4 NW 1/4 SE 1/4 NE 1/4 SE 1/4 SW 1/4 SE 1/4 SE 1/4 SE 1/4		
T7S	R3W	11	ALL		
T7S	R3W	12	NW 1/4 NW 1/4 SW 1/4 NW 1/4		
T7S	R3W	14	NW 1/4 NW 1/4 NE 1/4 NW 1/4 NW 1/4 NE 1/4 NE 1/4 NE 1/4		
T7S	R3W	15	NE 1/4 NE 1/4 NE 1/4 NE 1/4		

Also area to be irrigated in the future.

15. If the ground water supply is supplemental to an existing water supply, identification of any application for a permit, permit, certificate or adjudicated right to appropriate water made or held by the registrant.

Township 75 Range 3W, W.M.  
North

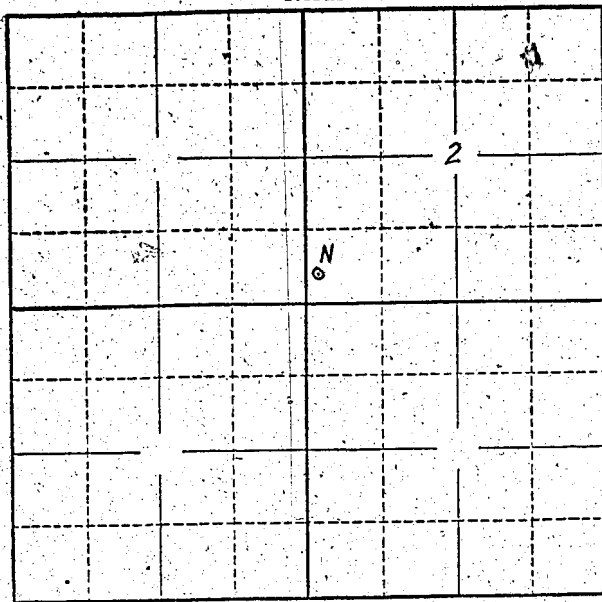

Locate well and acreage of irrigated land on plat.  
Scale: 2" = 1 Mile

STATE OF OREGON }  
County of Marion } ss.

I, D. P. Seater, being first duly sworn, do hereby certify that I have read the foregoing Registration Statement and that all of the items therein contained are true to the best of my knowledge and belief.

D. P. Seater  
(Signature of Registrant)

Subscribed and sworn to before me this 29th day of July, 1958

My commission expires Oct. 31, 1959 H. J. Hutto  
(Notary Public)

(SEAL)

**CERTIFICATE OF REGISTRATION**

STATE OF OREGON }  
County of Marion } ss.

This is to certify that the foregoing Registration Statement was received in the office of the State Engineer on the 30th day of July, 1958, at 8:30 o'clock A. M. and has been duly recorded in said office in Book No. 12 of Registration Statements on page GR-2872

Witness my hand this 25th day of May, 1959

Laura A. Stanley  
(State Engineer)

By \_\_\_\_\_  
(Deputy)

GR 2872

\$20.00