

# Registration Statement

## OF CLAIMANT OF RIGHT TO APPROPRIATE GROUND WATER

TO THE STATE ENGINEER OF OREGON:

I, Harlan C. Delby  
 of 3195 Walker Rd; Delton County of Wallowa  
(Mailing address)  
 State of Oregon do hereby make application for a certificate of registration as evidence  
 of a right to appropriate ground water.

1. Source from which water is withdrawn is Pump well  
(Flowing well, pump well, infiltration trench, or tunnel)

2. Location is: 5 miles N.E. of Delton Oregon  
(Approximate distance and direction from nearest city or town)

and is more particularly described as follows:

(a) N 8° 40' E - 28.5 chains & 100' W. S. from S.E. Corner W.J. Herken DLC 48  
(Give distance and bearing to corner of section or other legal subdivision)

being within NE 1/4 NW 1/4 of Sec. 17, Twp. 7 South, Rge. 2 West  
(Smallest legal subdivision) (N. or S.) (E. or W.)

or (b) within limits of recorded platted property, town or city:

in Lot \_\_\_\_\_, Block \_\_\_\_\_ of \_\_\_\_\_  
(Name of plat or addition)

County of \_\_\_\_\_  
(If within city or town, give name)

3. Construction Work was begun on 1949; was completed on 1959  
(Date) (Date)

and the ground water claimed was first used for the purposes set out below on 1954  
(Date)

since which time the water has been used intermittently  
(Continuously or Intermittently)

from May to Oct.  
(Date) (Date)

4. Quantity of water claimed and used is 2400 gallons per minute; \_\_\_\_\_ acre  
 feet per year.

5. Purpose or Purposes for which water is used irrigation

(Domestic, irrigation, municipal, manufacturing, industrial, etc.)

6. Description of Well: Depth 9.2 feet. Type drilled  
(Dug or drilled)

diameter 6 inches. Elevation of ground at well site unknown feet, mean sea level.  
(As near as known)

Depth to water table 25' feet. 1949

7. Capacity of Well: \_\_\_\_\_ g.p.m. with no test feet drawdown.

\_\_\_\_\_ g.p.m. with \_\_\_\_\_ feet drawdown.

Date of test \_\_\_\_\_

If Flowing Well: Measured discharge \_\_\_\_\_ g.p.m. on \_\_\_\_\_  
(Date)

Shut-in pressure at ground surface \_\_\_\_\_ lbs. per sq. in. on \_\_\_\_\_  
(Date)

Water is controlled by \_\_\_\_\_  
(Cap, valve, etc.)

8. Casing: (Give diameter, commercial specifications and depth below ground surface of each casing size.)

6 inch diameter *full depth* from ..... to *92'* feet  
..... inch diameter ..... from ..... to ..... feet  
..... inch diameter ..... from ..... to ..... feet  
..... inch diameter ..... from ..... to ..... feet

Describe and show depth of shoe, plug, adapter, liner or other details: .....

9. Perforated Casings or Screens:

*None* from ..... to .....  
(Number per foot and size of perforations, or describe screen)  
..... from ..... to .....  
..... from ..... to .....  
..... from ..... to .....

10. Log of Well: (Describe each stratum or formation clearly, indicate if water bearing, and give thickness and depth as indicated.)

MATERIAL	Thickness (Feet)	Depth to Bottom (Feet)
.....	.....	.....
.....	.....	.....
If log of well is not available, give name and address of driller. Stadelic  
Shererton, Or

11. Infiltration Trench: Covered or open .....  
 Dimensions: Length ..... ft. Minimum depth ..... ft. Maximum depth ..... ft.  
 Bottom width ..... ft. Discharge ..... g.p.m. Date of test .....

12. Tunnel: Type of lining .....  
 Dimensions: ..... (Length, course, and cross sectional size)  
 Position of water bearing stratum with reference to portal of tunnel .....

Log of tunnel: (Preceding table for log of well may be used, if desired. Give footage from portal and character of materials, as pertinent.)


13. Pumping Equipment:  
 (a) Pump Deep well jet Capacity 40 g.p.m.  
(Make, type and size)  
 (b) Motor 2hp.  
(Type and horsepower)

14. Location of area irrigated or to be irrigated, or place of use if for purposes other than irrigation.

Township North or South	Range E. or W. of Willamette Meridian	Section	Forty-acre Tract	Number Acres To Be Irrigated	Date of Reclamation
75	20	17	NE $\frac{1}{4}$ <sup>NW</sup> <del>SW</del> $\frac{1}{4}$	4.0	1954

15. If the ground water supply is supplemental to an existing water supply, identification of any application for a permit, permit, certificate or adjudicated right to appropriate water made or held by the registrant.  
None

Township 7S Range 2W, W.M.  
North

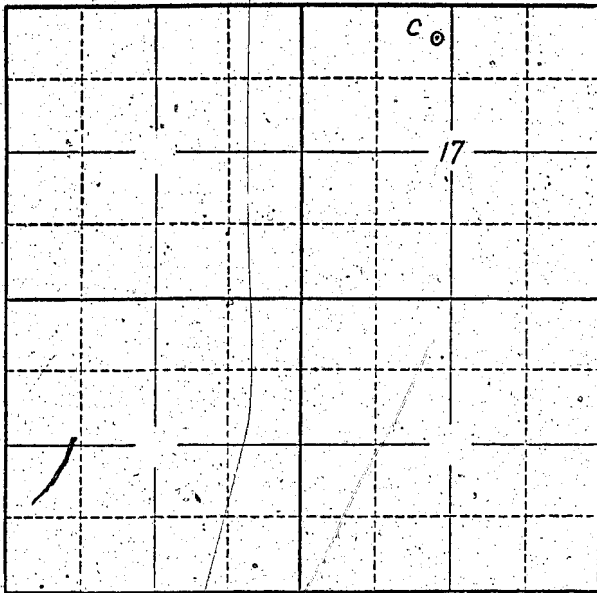

Locate well and acreage of irrigated land on plat.  
Scale: 2" = 1 Mile

STATE OF OREGON

County of \_\_\_\_\_ } ss.

I, Harlan B. Kellogg, being first duly sworn, do hereby certify that I have read the foregoing Registration Statement and that all of the items therein contained are true to the best of my knowledge and belief.

Harlan B. Kellogg  
(Signature of Registrant)

Subscribed and sworn to before me this 30 day of July, 1958.

My commission expires 9/27/58

Jessie Baxter  
(Notary Public)

(SEAL)

### CERTIFICATE OF REGISTRATION

STATE OF OREGON

County of Marion } ss.

This is to certify that the foregoing Registration Statement was received in the office of the State Engineer on the 30th day of July, 1958, at 1:30 o'clock P. M. and has been duly recorded in said office in Book No. 12 of Registration Statements on page GR-2874.

Witness my hand this 25th day of May, 1959.

Lawrence A. Stanley  
(State Engineer)

By \_\_\_\_\_  
(Deputy)

\$1.50

GR - 2874